

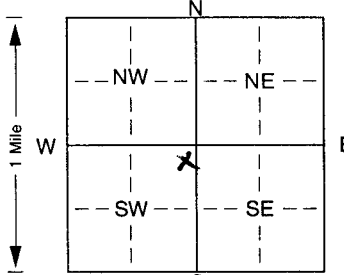
MW #2

WATER WELL RECORD Form WWC-5 KSA 82a-1212 ID No.

| |
|--|
| 1 LOCATION OF WATER WELL: County: <u>Harvey</u> Fraction: <u>NE 1/4 NE 1/4 SW 1/4</u> Section Number: <u>8</u> Township Number: <u>T 23 S</u> Range Number: <u>R 1</u> <u>EW</u> |
|--|

Distance and direction from nearest town or city street address of well if located within city?
1823 N Main St Newton, KS

| | |
|--|--|
| 2 WATER WELL OWNER: <u>PRIME TIME STAIRS INC</u> RR#, St. Address, Box #: <u>943 E Hwy 76</u> City, State, ZIP Code: <u>BRUNSON MO 65616</u> | Board of Agriculture, Division of Water Resources Application Number: |
|--|--|

| | |
|--|--|
| 3 LOCATE WELL'S LOCATION WITH AN "X" IN SECTION BOX:  | 4 DEPTH OF COMPLETED WELL: <u>1.7</u> ft. ELEVATION: Depth(s) Groundwater Encountered 1. <u>1.7</u> ft. 2. ft. 3. ft. WELL'S STATIC WATER LEVEL ft. below land surface measured on mo/day/yr Pump test data: Well water was ft. after hours pumping gpm Est. Yield gpm: Well water was ft. after hours pumping gpm Bore Hole Diameter. <u>7.1/4</u> in. to <u>1.7</u> ft., and in. to ft. WELL WATER TO BE USED AS: 5 Public water supply 8 Air conditioning 11 Injection well 1 Domestic 3 Feedlot 6 Oil field water supply 9 Dewatering 12 Other (Specify below) 2 Irrigation 4 Industrial 7 Domestic (lawn & garden) <input checked="" type="radio"/> Monitoring well Was a chemical/bacteriological sample submitted to Department? Yes. No. <input checked="" type="checkbox"/> ; If yes, mo/day/yr sample was submitted Water Well Disinfected? Yes No <input checked="" type="checkbox"/> |
|--|--|

| |
|--|
| 5 TYPE OF BLANK CASING USED: 1 Steel 3 RMP (SR) 5 Wrought iron 8 Concrete tile CASING JOINTS: Glued. Clamped. <input checked="" type="radio"/> PVC 4 ABS 6 Asbestos-Cement 9 Other (specify below) Welded Blank casing diameter <u>2</u> in. to <u>7</u> ft., Dia in. to ft., Dia in. to ft. Casing height above land surface. <u>0</u> in., weight <u>Sched 40</u> lbs./ft. Wall thickness or gauge No. TYPE OF SCREEN OR PERFORATION MATERIAL: <input checked="" type="radio"/> PVC 10 Asbestos-cement 1 Steel 3 Stainless steel 5 Fiberglass 8 RMP (SR) 11 Other (specify) 2 Brass 4 Galvanized steel 6 Concrete tile 9 ABS 12 None used (open hole) SCREEN OR PERFORATION OPENINGS ARE: 5 Gauzed wrapped 8 Saw cut 11 None (open hole) 1 Continuous slot <input checked="" type="radio"/> Mill slot <u>0.10</u> 6 Wire wrapped 9 Drilled holes 2 Louvered shutter 4 Key punched 7 Torch cut 10 Other (specify) ft. SCREEN-PERFORATED INTERVALS: From <u>1.7</u> ft. to <u>7</u> ft., From ft. to ft. GRAVEL PACK INTERVALS: From <u>1.7</u> ft. to <u>5</u> ft., From ft. to ft. |
|--|

| |
|---|
| 6 GROUT MATERIAL: 1 Neat cement <input checked="" type="radio"/> Cement grout <input checked="" type="radio"/> Bentonite 4 Other Grout Intervals: From <u>2</u> ft. to <u>3</u> ft., From <u>5</u> ft. to <u>2</u> ft., From ft. to ft. What is the nearest source of possible contamination: 1 Septic tank 4 Lateral lines 7 Pit privy 10 Livestock pens 14 Abandoned water well 2 Sewer lines 5 Cess pool 8 Sewage lagoon 11 Fuel storage 15 Oil well/Gas well <input checked="" type="radio"/> Watertight sewer lines 6 Seepage pit 9 Feedyard 12 Fertilizer storage 16 Other (specify below) Direction from well? <u>West</u> How many feet? <u>11'</u> |
|---|

| FROM | TO | LITHOLOGIC LOG | FROM | TO | PLUGGING INTERVALS |
|------|----|---------------------------------------|------|----|--------------------|
| 0 | 5 | Concrete | | | |
| 5 | 6 | thin silty clay | | | |
| 6 | 8 | silty sandy clay | | | |
| 8 | 15 | solid to clayey sand with <u>0.13</u> | | | |

| |
|--|
| 7 CONTRACTOR'S OR LANDOWNER'S CERTIFICATION: This water well was <input checked="" type="radio"/> constructed, (2) reconstructed, or (3) plugged under my jurisdiction and was completed on (mo/day/year) <u>8-26-02</u> and this record is true to the best of my knowledge and belief. Kansas Water Well Contractor's Licence No. <u>575</u> . This Water Well Record was completed on (mo/day/yr) under the business name of <u>FUNKER Drilling SERVICE INC</u> by (signature) <u>[Signature]</u> |
|--|