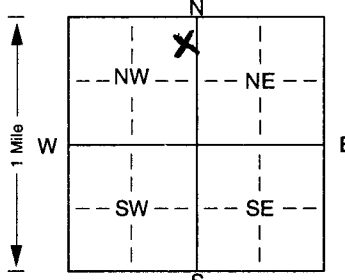


1 LOCATION OF WATER WELL: Fraction 7 1/2 No 1/4 NW 1/4 Section Number 18 Township Number T 23 S Range Number R 1 E  
 County: Harvey

Distance and direction from nearest town or city street address of well if located within city?  
In City Newton 1204 Trinity Ct.

2 WATER WELL OWNER: Phil Stallings  
 RR#, St. Address, Box # : 1204 Trinity Ct. Board of Agriculture, Division of Water Resources  
 City, State, ZIP Code : Newton, KS 67114 Application Number:

3 LOCATE WELL'S LOCATION WITH AN "X" IN SECTION BOX:  4 DEPTH OF COMPLETED WELL: 70 ft. ELEVATION:  
 Depth(s) Groundwater Encountered 1. 50 ft. 2. . ft. 3. . ft.  
 WELL'S STATIC WATER LEVEL . 22 ft. below land surface measured on mo/day/yr 9-6-02  
 Pump test data: Well water was . ft. after . hours pumping . gpm  
 Est. Yield 20 gpm Well water was . ft. after . hours pumping . gpm  
 Bore Hole Diameter. 8 1/2 in. to 70 ft., and . in. to . ft.  
 WELL WATER TO BE USED AS: 5 Public water supply 8 Air conditioning 11 Injection well  
 1 Domestic 3 Feedlot 6 Oil field water supply 9 Dewatering 12 Other (Specify below)  
 2 Irrigation 4 Industrial 7 Domestic (lawn & garden) 10 Monitoring well .  
 Was a chemical/bacteriological sample submitted to Department? Yes. . No. X; If yes, mo/day/yr sample was submitted  
 Water Well Disinfected? Yes X No

5 TYPE OF BLANK CASING USED: 5 Wrought iron 8 Concrete tile CASING JOINTS: Glued. X Clamped. .  
 1 Steel 3 RMP (SR) 6 Asbestos-Cement 9 Other (specify below) Welded .  
 2 PVC 4 ABS 7 Fiberglass . Threaded. .  
 Blank casing diameter . 5 in. to 40 ft., Dia . in. to . ft., Dia . in. to . ft.  
 Casing height above land surface. 12 in., weight Class 160 lbs./ft. Wall thickness or gauge No. 214  
 TYPE OF SCREEN OR PERFORATION MATERIAL: 7 PVC 10 Asbestos-cement  
 1 Steel 3 Stainless steel 5 Fiberglass 8 RMP (SR) 11 Other (specify) .  
 2 Brass 4 Galvanized steel 6 Concrete tile 9 ABS 12 None used (open hole)  
 SCREEN OR PERFORATION OPENINGS ARE: 5 Gauzed wrapped 8 Saw cut 11 None (open hole)  
 1 Continuous slot 3 Mill slot 6 Wire wrapped 9 Drilled holes  
 2 Louvered shutter 4 Key punched 7 Torch cut 10 Other (specify) . ft.  
 SCREEN-PERFORATED INTERVALS: From . ft. to . ft., From . ft. to . ft.  
 GRAVEL PACK INTERVALS: From . ft. to . ft., From . ft. to . ft.

6 GROUT MATERIAL: 1 Neat cement 2 Cement grout 3 Bentonite 4 Other .  
 Grout Intervals: From . 0 ft. to 20 ft., From . ft. to . ft., From . ft. to . ft.  
 What is the nearest source of possible contamination: 10 Livestock pens 14 Abandoned water well  
 1 Septic tank 4 Lateral lines 7 Pit privy 11 Fuel storage 15 Oil well/Gas well  
 2 Sewer lines 5 Cess pool 8 Sewage lagoon 12 Fertilizer storage 16 Other (specify below)  
 3 Watertight sewer lines 6 Seepage pit 9 Feedyard 13 Insecticide storage .  
 Direction from well? S How many feet? 20

FROM	TO	LITHOLOGIC LOG	FROM	TO	PLUGGING INTERVALS
<u>0</u>	<u>24</u>	<u>Clay</u>			
<u>24</u>	<u>35</u>	<u>Fine Sand &amp; mixed Clay</u>			
<u>35</u>	<u>40</u>	<u>Fine Sand</u>			
<u>40</u>	<u>53</u>	<u>Fine to med Sand</u>			
<u>53</u>	<u>70</u>	<u>Blue - Gray Shale</u>			

7 CONTRACTOR'S OR LANDOWNER'S CERTIFICATION: This water well was (1) constructed, (2) reconstructed, or (3) plugged under my jurisdiction and was completed on (mo/day/year) 9-6-02 and this record is true to the best of my knowledge and belief. Kansas Water Well Contractor's Licence No. 180 This Water Well Record was completed on (mo/day/yr) 9-6-02 under the business name of Backhus Drilling by (signature) Paul Backhus