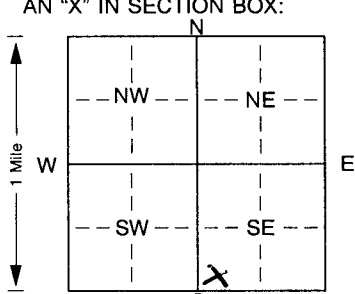


County: Harvey Distance and direction from nearest town or city street address of well if located within city? 1300 N Main Newton Ks MW# 2-R

2 WATER WELL OWNER: 12th Main LLC RR#, St. Address, Box #: 201 S. Kansas Ave Board of Agriculture, Division of Water Resources City, State, ZIP Code: Topeka Ks 66603 Application Number:

3 LOCATE WELL'S LOCATION WITH AN "X" IN SECTION BOX:  4 DEPTH OF COMPLETED WELL: 16 ft. ELEVATION: Depth(s) Groundwater Encountered 1. 16 ft. 2. ft. 3. ft. WELL'S STATIC WATER LEVEL: ft. below land surface measured on mo/day/yr Pump test data: Well water was ft. after hours pumping gpm Est. Yield gpm: Well water was ft. after hours pumping gpm Bore Hole Diameter: 8 in. to 16 in. to in. to ft. WELL WATER TO BE USED AS: 5 Public water supply 8 Air conditioning 11 Injection well 1 Domestic 3 Feedlot 6 Oil field water supply 9 Dewatering 12 Other (Specify below) 2 Irrigation 4 Industrial 7 Domestic (lawn & garden) Monitoring well Was a chemical/bacteriological sample submitted to Department? Yes. No. —; If yes, mo/day/yr sample was submitted Water Well Disinfected? Yes No —

5 TYPE OF BLANK CASING USED: 1 Steel 3 RMP (SR) 5 Wrought iron 8 Concrete tile CASING JOINTS: Glued. Clamped. 2 Brass 4 Galvanized steel 6 Asbestos-Cement 9 Other (specify below) Welded 3 Fiberglass Threaded PVC 4 ABS 7 Fiberglass Threaded Blank casing diameter: 2 in. to 6 ft., Dia. in. to ft., Dia. in. to ft. Casing height above land surface: 0 in., weight: Sched. 40 lbs./ft. Wall thickness or gauge No. TYPE OF SCREEN OR PERFORATION MATERIAL: 1 Steel 3 Stainless steel 5 Fiberglass 8 RMP (SR) 10 Asbestos-cement 2 Brass 4 Galvanized steel 6 Concrete tile 9 ABS 11 Other (specify) 12 None used (open hole) SCREEN OR PERFORATION OPENINGS ARE: 1 Continuous slot 2 Louvered shutter 3 Mill slot 0.10 4 Key punched 5 Gauzed wrapped 6 Wire wrapped 7 Torch cut 8 Saw cut 9 Drilled holes 10 Other (specify) 11 None (open hole) SCREEN-PERFORATED INTERVALS: From 16 ft. to 6 ft., From ft. to ft. GRAVEL PACK INTERVALS: From 16 ft. to 4.5 ft., From ft. to ft. From ft. to ft. From ft. to ft.

6 GROUT MATERIAL: 1 Neat cement 2 Cement grout 3 Bentonite 4 Other Grout Intervals: From 2 ft. to ft., From 4.5 ft. to 2 ft., From ft. to ft. What is the nearest source of possible contamination: 1 Septic tank 4 Lateral lines 7 Pit privy 10 Livestock pens 14 Abandoned water well 2 Sewer lines 5 Cess pool 8 Sewage lagoon 11 Fuel storage 15 Oil well/Gas well 3 Watertight sewer lines 6 Seepage pit 9 Feedyard 12 Fertilizer storage 16 Other (specify below) 13 Insecticide storage Direction from well? West How many feet? 52

FROM	TO	LITHOLOGIC LOG	FROM	TO	PLUGGING INTERVALS
0	0.8	Asphalt			
0.8	4.5	Fill Clay Brn Brick Concrete Silty			
4.5	11	Brn silty clay Gray Mottled			
11	16	Brn silty slightly sandy Very Moist Clay			

7 CONTRACTOR'S OR LANDOWNER'S CERTIFICATION: This water well was constructed, (2) reconstructed, or (3) plugged under my jurisdiction and was completed on (mo/day/year) 11-26-02 and this record is true to the best of my knowledge and belief. Kansas Water Well Contractor's Licence No. 575 This Water Well Record was completed on (mo/day/yr) 12-12-02 under the business name of FUN KEY Drilling Service Inc by (signature) [Signature]