

1	LOCATION OF WATER WELL:	Fraction	Section Number	Township Number	Range Number
County:	Harvey	SW $\frac{1}{4}$ NE $\frac{1}{4}$ SE $\frac{1}{4}$	29	T 23 S	R 1 E

Distance and direction from nearest town or city street address of well if located within city?

In City Newton Sw 24th


2	WATER WELL OWNER: R. J. TIPPIN
---	--------------------------------

RR#, St. Address, Box # : Box 193
City, State, ZIP Code : Elbing, KS. 67041

Board of Agriculture, Division of Water Resources
Application Number:

3	LOCATE WELL'S LOCATION WITH	4	DEPTH OF COMPLETED WELL 110 ft. ELEVATION:
---	-----------------------------	---	--

AN "X" IN SECTION BOX:

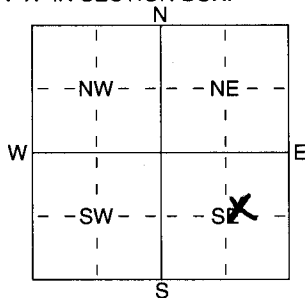

Depth(s) Groundwater Encountered 8.0 ft. 1 8.0 ft. 2 9.5 ft. 3 0.3 ft.
WELL'S STATIC WATER LEVEL 8.0 ft. below land surface measured on mo/day/yr 9-5-03

Pump test data:		Well water was	ft. after	hours pumping	gpm
Est. Yield	2.0 gpm	Well water was	ft. after	hours pumping	gpm
WELL WATER TO BE USED AS:					
1 Domestic	3 Feedlot	5 Public water supply	8 Air conditioning	11 Injection well	
2 Irrigation	4 Industrial	6 Oil field water supply	9 Dewatering	12 Other (Specify below)	
		7 Domestic (lawn & garden)	10 Monitoring well		

Was a chemical/bacteriological sample submitted to Department? Yes No; If yes, mo/day/yr sample was submitted
Water Well Disinfected? Yes No

5	TYPE OF BLANK CASING USED:
---	----------------------------

1 Steel	3 RMP (SR)
2 PVC	4 ABS

5 Wrought iron
6 Asbestos-Cement
7 Fiberglass

8 Concrete tile
9 Other (specify below)

CASING JOINTS: Glued Clamped
Welded
Threaded

Blank casing diameter 5 in. to 70 ft., Dia 50 in. to _____ ft., Dia _____ in. to _____ ft.

Casing height above land surface 12 in., weight CLASS 160 lbs./ft. Wall thickness or gauge No. 214

TYPE OF SCREEN OR PERFORATION MATERIAL:

1 Steel
2 Brass
3 Stainless Steel
4 Galvanized Steel

5 Fiberglass
6 Concrete tile

7 PVC
8 RMP (SR)
9 ABS

10 Asbestos-Cement
11 Other (Specify)
12 None used (open hole)

SCREEN OR PERFORATION OPENINGS ARE:

1 Continuous slot	3 Mill slot
2 Louvered shutter	4 Key punched

5 Guazed wrapped
6 Wire wrapped
7 Torch cut

8 Saw cut
9 Drilled holes
10 Other (specify) ft.

SCREEN-PERFORATED INTERVALS: From 70 ft. to 110 ft., From _____ ft. to _____ ft.
From _____ ft. to _____ ft., From _____ ft. to _____ ft.

GRAVEL PACK INTERVALS: From ft. to ft., From ft. to ft.
From ft. to ft., From ft. to ft.

6 GROUT MATERIAL: 1 Neat cement 2 Cement grout 3 Bentonite 4 Other.....
Grout Intervals: From 0 ft. to 20 ft., From ft. to ft., From ft. to ft.

What is the nearest source of possible contamination:

1 Septic tank	4 Lateral lines
2 Sewer lines	5 Cess pool
3 Watertight sewer lines	6 Seepage pit

7 Pit privy
8 Sewage lagoon
9 Feedyard

10 Livestock pens	14 Abandoned water well
11 Fuel storage	15 Oil well/Gas well
12 Fertilizer storage	16 Other (specify below)
13 Insecticide storage

Direction from well? SW How many feet? 50 +

[illegible]

7 CONTRACTOR'S OR LANDOWNER'S CERTIFICATION: This water well was (1) constructed, (2) reconstructed, or (3) plugged under my jurisdiction and was completed on (mo/day/year) 9-5-03 and this record is true to the best of my knowledge and belief. Kansas Water Well Contractor's Licence No. 122 This Water Well Record was completed on (mo/day/yr) 9-9-03 under the business name of Boekhorst Drilling by (signature) Boekhorst Drilling