


1	LOCATION OF WATER WELL:	Fraction	Section Number	Township Number	Range Number
	County: <u>HARVEY</u>	<u>NE 1/4 SE 1/4 NE 1/4</u>	<u>19</u>	<u>T 23 S</u>	<u>R 1</u> <u>EW</u>

Distance and direction from nearest town or city street address of well if located within city?  
SOUTH WEST of 1st ST AND Plum STREET IN NEWTON, KS

2	WATER WELL OWNER: <u>BURLINGTON NORTHERN SANTA FE</u>	<u>RW-2 (SOUTH)</u>
	RR #, St. Address, Box #: <u>4200 DEEN ROAD</u>	<u>(RECOVERY WELL)</u>
	City, State, ZIP Code: <u>FORT WORTH, TX 76106</u>	Board of Agriculture, Division of Water Resources Application Number:

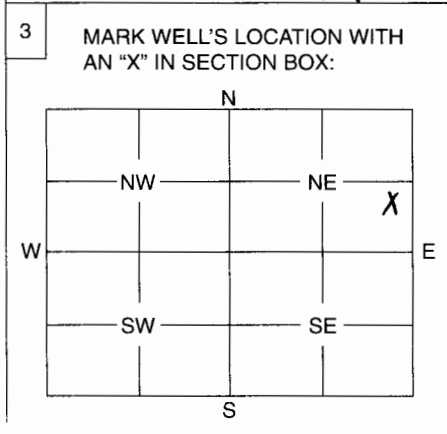

4 DEPTH OF WELL ..... 9.31 ft.

WELL'S STATIC WATER LEVEL ..... 9 ft.

WELL WAS USED AS:

1 Domestic	5 Public Water Supply	9 Dewatering
2 Irrigation	6 Oil Field Water Supply	10 Monitoring Well
3 Feedlot	7 Domestic (Lawn & Garden)	11 Injection Well
4 Industrial	8 Air Conditioning	12 Other <u>RECOVERY WELL</u>

Was a chemical / bacteriological sample submitted to Department? Yes ..... No

If yes, mo/day/yr sample was submitted .....

Water Well Disinfected: Yes  No .....

5 TYPE OF BLANK CASING USED:

Steel    3 RMP (SR)    5 Wrought    7 Fiberglass    9 Other (Specify below)

2 PVC    4 ABS    6 Asbestos-Cement    8 Concrete Tile

Blank casing diameter ..... 2.4 in.    Was casing pulled?    Yes .....    No     If yes, how much .....

Casing height above or below land surface ..... 3.6 in.

6 GROUT PLUG MATERIAL:    1 Neat cement     Cement grout     Bentonite     Other NATIVE SOIL

Grout Plug Intervals:    2 From ..... 3 ft. to ..... 9.31 ft.,    3 From ..... 0.5 ft. to ..... 3 ft.,    4 From ..... 0 to ..... 0.5 ft.

What is the nearest source of possible contamination:

1 Septic tank	6 Seepage pit	11 Fuel storage	<input checked="" type="radio"/> Other (specify below)
2 Sewer lines	7 Pit privy	12 Fertilizer storage	<u>DIESEL FUEL</u>
3 Watertight sewer lines	8 Sewage lagoon	13 Insecticide storage	
4 Lateral lines	9 Feedyard	14 Abandoned water well	
5 Cess pool	10 Livestock pens	15 Oil well/Gas well	

Direction from well? ..... ON PROPERTY    How many feet? ..... 0

FROM	TO	PLUGGING MATERIALS
<u>0</u>	<u>0.5</u>	<u>NATIVE SOIL</u>
<u>0.5</u>	<u>3</u>	<u>BENTONITE - HOLEPLUG</u>
<u>3</u>	<u>9.31</u>	<u>CEMENT GROUT</u>

7 CONTRACTOR'S OF LANDOWNER'S CERTIFICATION: This water well was plugged under my jurisdiction and was completed on (mo/day/year) ..... AUGUST 24, 2004 ..... and this record is true to the best of my knowledge and belief. Kansas Water Well Contractor's License No. 581 This Water Well Record was completed on (mo/day/year) 9-2-04 under the business name of LAYNE CHRISTENSEN COMPANY by (signature) [Signature]

INSTRUCTIONS: Use typewriter or ball point pen. Please press firmly and print clearly. Please fill in blanks, underline or circle the correct answers. Send top three copies to Kansas Department of Health and Environment, Bureau of Water, Geology Section, 1000 SW Jackson St., Ste. 420, Topeka, Kansas 66612-1367. Telephone: 785/296-5522. Send one to Water Well Owner and retain one for your records.