


1	LOCATION OF WATER WELL:	Fraction	Section	Number	Township	Number	Range	Number
	County: <u>HARVEY</u>	<u>NE 1/4 SE 1/4 NE 1/4</u>	<u>19</u>		<u>T 23 S</u>		<u>R 1</u>	<u>(E)W</u>

Distance and direction from nearest town or city street address of well if located within city?  
SOUTH WEST OF 1ST ST. AND PLUM ST. IN NEWTON, KS

2	WATER WELL OWNER: <u>BURLINGTON NORTHERN SANTA FE</u>	MW-31 SOUTH
	RR #, St. Address, Box #: <u>4200 DEEN ROAD</u>	(MONITORING WELL)
	City, State, ZIP Code: <u>FORT WORTH, TX 76106</u>	Board of Agriculture, Division of Water Resources
		Application Number:

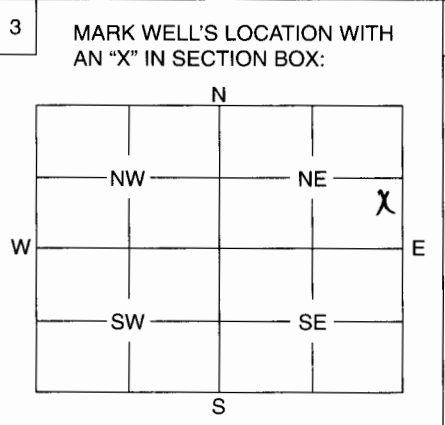

4 DEPTH OF WELL ..... 15 ..... ft.

WELL'S STATIC WATER LEVEL ..... 9 ..... ft.

WELL WAS USED AS:

1 Domestic	5 Public Water Supply	9 Dewatering
2 Irrigation	6 Oil Field Water Supply	<u>10</u> Monitoring Well
3 Feedlot	7 Domestic (Lawn & Garden)	11 Injection Well
4 Industrial	8 Air Conditioning	12 Other .....

Was a chemical / bacteriological sample submitted to Department? Yes ..... No  .....

If yes, mo/day/yr sample was submitted .....

Water Well Disinfected: Yes  ..... No .....

5 TYPE OF BLANK CASING USED:

<u>1</u> Steel	3 RMP (SR)	5 Wrought	7 Fiberglass	9 Other (Specify below)
2 PVC	4 ABS	6 Asbestos-Cement	8 Concrete Tile	

Blank casing diameter ..... 3 ..... in. Was casing pulled? Yes ..... No  ..... If yes, how much .....

Casing height above or below land surface ..... 36 ..... in.

6 GROUT PLUG MATERIAL: 1 Neat cement 2 Cement grout 3 Bentonite 4 Other NATIVE SOIL

Grout Plug Intervals: 2 From 3 ft. to 15 ft., 3 From 0.5 ft. to 3 ft., 4 From 0 to 0.5 ft.

What is the nearest source of possible contamination:

1 Septic tank	6 Seepage pit	11 Fuel storage
2 Sewer lines	7 Pit privy	12 Fertilizer storage
3 Watertight sewer lines	8 Sewage lagoon	13 Insecticide storage
4 Lateral lines	9 Feedyard	14 Abandoned water well
5 Cess pool	10 Livestock pens	15 Oil well/Gas well

16 Other (specify below) DIESEL FUEL

Direction from well? ... ON PROPERTY ..... How many feet? ..... 0 .....

FROM	TO	PLUGGING MATERIALS
<u>0</u>	<u>0.5</u>	<u>NATIVE SOIL</u>
<u>0.5</u>	<u>3</u>	<u>BENTONITE-HOLEPLUG</u>
<u>3</u>	<u>15</u>	<u>CEMENT GROUT</u>

REC'D  
 SEP 26 2004  
 BUREAU OF WATER

7 CONTRACTOR'S OF LANDOWNER'S CERTIFICATION: This water well was plugged under my jurisdiction and was completed on (mo/day/year) AUGUST 24, 2004 and this record is true to the best of my knowledge and belief. Kansas Water Well Contractor's License No. 581 This Water Well Record was completed on (mo/day/year) 9-8-04 under the business name of LAYNE CHRISTENSEN COMPANY by (signature) [Signature]

INSTRUCTIONS: Use typewriter or ball point pen. Please press firmly and print clearly. Please fill in blanks, underline or circle the correct answers. Send top three copies to Kansas Department of Health and Environment, Bureau of Water, Geology Section, 1000 SW Jackson St., Ste. 420, Topeka, Kansas 66612-1367. Telephone: 785/296-5522. Send one to Water Well Owner and retain one for your records.