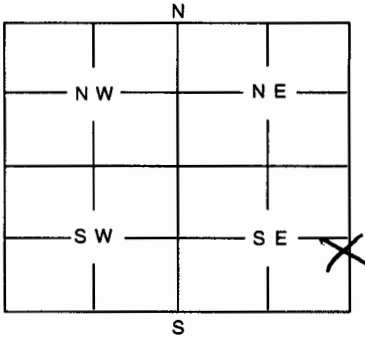


1	LOCATION OF WATER WELL: County: <u>Harvey</u>	Fraction <u>NE 1/4 SE 1/4 SE 1/4</u>	Section Number <u>16</u>	Township Number <u>23</u>	Range Number <u>1E</u>
---	--	---	-----------------------------	------------------------------	---------------------------

Distance and direction from nearest town or city street address of well if located within city?
200 Manchester, Newton

2	WATER WELL OWNER: <u>Newell Oil Co.</u> RR #, St. Address, Box #: <u>Newton, Ks</u> City, State, ZIP Code :	<u>mw4</u> Board of Agriculture, Division of Water Resources Application Number:
---	---	--

3	MARK WELL'S LOCATION WITH AN "X" IN SECTION BOX: 	4	DEPTH OF WELL <u>13</u> ft WELL'S STATIC WATER LEVEL <u>NM</u> ft WELL WAS USED AS: 1 Domestic 5 Public Water Supply 9 Dewatering 2 Irrigation 6 Oil Field Water Supply <u>10</u> Monitoring Well 3 Feedlot 7 Domestic (Lawn & Garden) 11 Injection Well 4 Industrial 8 Air Conditioning 12 Other Was a chemical / bacteriological sample submitted to Department? Yes <u>No</u> If yes, mo/day/yr sample was submitted Water Well Disinfected: Yes <u>No</u>
---	--	---	---

5	TYPE OF BLANK CASING USED: 1 Steel 3 RMP (SR) 5 Wrought 7 Fiberglass 9 Other (Specify below) <u>2</u> PVC 4 ABS 6 Asbestos-Cement 8 Concrete Tile Blank casing diameter <u>2</u> in. Was casing pulled? Yes <u>X</u> No If yes, how much <u>13 ft.</u> Casing height above or below land surface in.
---	---

6	GROUT PLUG MATERIAL: 1 Neat cement <u>2</u> Cement grout 3 Bentonite 4 Other Grout Plug Intervals: From <u>0</u> ft. to <u>13</u> ft., From ft. to ft., From to ft. What is the nearest source of possible contamination: 1 Septic tank 6 Seepage pit <u>11</u> Fuel storage 16 Other (specify below) 2 Sewer lines 7 Pit privy 12 Fertilizer storage 3 Watertight sewer lines 8 Sewage lagoon 13 Insecticide storage 4 Lateral lines 9 Feedyard 14 Abandoned water well 5 Cess Pool 10 Livestock pens 15 Oil well/Gas well Direction from well? How many feet?
---	--

FROM	TO	PLUGGING MATERIALS
<u>0</u>	<u>13</u>	<u>Cement Grout</u>

RECEIVED
SEP 22 2004
BUREAU OF WATER

7	CONTRACTOR'S OR LANDOWNER'S CERTIFICATION: This water well was plugged under my jurisdiction and was completed on (mo/day/year) <u>9/20/09</u> and this record is true to the best of my knowledge and belief. Kansas Water Well Contractor's License No. by (signature) <u>[Signature]</u> under the business name of <u>Larsen, Debold + Associates</u> This Water Well Record was completed on (mo/day/year)
---	---

INSTRUCTIONS: Use typewriter or ball point pen. Please press firmly and print clearly. Please fill in blanks, underline or circle the correct answers. Send top three copies to Kansas Department of Health and Environment, Bureau of Water, Topeka, Kansas 66620-0001. Telephone: 785/296-3565. Send one to Water Well Owner and retain one for your records.