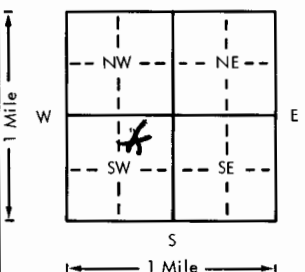


USE TYPEWRITER OR BALL POINT PEN-PRESS FIRMLY, PRINT CLEARLY.

WATER WELL RECORD  
KSA 82a-1201-1215

Kansas Department of Health and Environment-Division of Environment  
(Water well Contractors)  
Topeka, Kansas 66620

1. Location of well:	County <b>HARVEY</b>	Fraction <b>NW 1/4 NE 1/4 SW 1/4</b>	Section number <b>5</b>	Township number <b>T 23 S R 1</b>	Range number <b>1</b> <span style="border: 1px solid black; border-radius: 50%; padding: 2px;">E</span> <span style="border: 1px solid black; border-radius: 50%; padding: 2px;">W</span>
2. Distance and direction from nearest town or city: Street address of well location if in city: <b>SAME</b>			3. Owner of well: <b>Clayton Penner</b> R.R. or street: <b># 8 Sapphire Court</b> City, state, zip code: <b>N. Newton Kns, 67117</b>		
4. Locate with "X" in section below: N W E S 1 Mile		Sketch map: 		6. Bore hole dia <b>5 3/4</b> in. Completion date _____ Well depth <b>78</b> ft.	
5. Type and color of material		From To		7. <input type="checkbox"/> Cable tool <input checked="" type="checkbox"/> Rotary <input type="checkbox"/> Driven <input type="checkbox"/> Dug <input type="checkbox"/> Hollow rod <input type="checkbox"/> Jetted <input type="checkbox"/> Bored <input type="checkbox"/> Reverse rotary	
				8. Use: <input type="checkbox"/> Domestic <input type="checkbox"/> Public supply <input type="checkbox"/> Industry <input type="checkbox"/> Irrigation <input type="checkbox"/> Air conditioning <input type="checkbox"/> Stock <input checked="" type="checkbox"/> Lawn <input type="checkbox"/> Oil field water <input type="checkbox"/> Other	
green black shale		30 35		9. Casing: Material _____ Height: Above or below Threaded _____ <del>None</del> Surface _____ in. RMP _____ PVC _____ Weight _____ lbs./ft. Dia. _____ in. to _____ ft. depth Wall Thickness: inches or Dia. _____ in. to _____ ft. depth gage No. _____	
				10. Screen: Manufacturer's name _____ Type _____ Dia. _____ Slot/gauze <b>None</b> Length _____ Set between _____ ft. and _____ ft. _____ ft. and _____ ft. Gravel pack? <input type="checkbox"/> Size range of material _____	
Wellington shale		35 40		11. Static water level: _____ mo./day/yr. <b>14</b> ft. below land surface Date _____	
" grey - black		40 57		12. Pumping level below land surfaces: _____ ft. after _____ hrs. pumping _____ g.p.m. _____ ft. after _____ hrs. pumping _____ g.p.m. Estimated maximum yield _____ g.p.m.	
Fault		57 57 1/2		13. Water sample submitted: _____ mo./day/yr. <input type="checkbox"/> Yes <input type="checkbox"/> No Date _____	
Wellington shale		57 1/2 63		14. Well head completion: <input type="checkbox"/> Pitless adapter _____ Inches above grade	
white rock (hard - felspar)		63 67		15. Well grouted? _____ With: <input type="checkbox"/> Neat cement <input type="checkbox"/> Bentonite <input type="checkbox"/> Concrete Depth: From _____ ft. to _____ ft.	
faults		67 68		16. Nearest source of possible contamination: ft. _____ Direction _____ Type _____ Well disinfected upon completion? <input type="checkbox"/> Yes <input type="checkbox"/> No	
White Stone + Wellington layer		68 73		17. Pump: _____ Not installed Manufacturer's name _____ Model number _____ HP _____ Volts _____ Length of drop pipe _____ ft. capacity _____ g.p.m. Type: <input type="checkbox"/> Submersible <input type="checkbox"/> Turbine <input type="checkbox"/> Jet <input type="checkbox"/> Reciprocating <input type="checkbox"/> Centrifugal <input type="checkbox"/> Other	
Fault		73 73 1/2		20. Water well contractor's certification: This well was drilled under my jurisdiction and this report is true to the best of my knowledge and belief. <b>PAUL'S INC. #125</b> Business name _____ License No. _____ Address <b>Houston, Kns</b> Signed <b>Paul Bonillet</b> Date _____ Authorized representative	
Wellington - white stone layer		73 1/2 76			
Wellington - black		76 78			
(Use a second sheet if needed)					
18. Elevation: Topography: <input type="checkbox"/> Hill <input type="checkbox"/> Slope <input type="checkbox"/> Upland <input type="checkbox"/> Valley		19. Remarks: <b>ATTACH to log #</b> <b>for some well - dated 8/12/76</b> <b>drilled open hole 30'-78' in</b> <b>EXIST CASE WELL</b>			

T 23 S R 1 E W  
 Sec 5 NW 1/4 SW 1/4