

WATER WELL PLUGGING RECORD Form WWC-5P

KSA 82a-1212


ID NO.

MW-7

| | | | | |
|---|----------------------------|----------------------|-------------------------|-----------------------|
| 1 LOCATION OF WATER WELL: Harvey County | Fraction SE ¼ NW ¼ SE ¼ | Section Number 17 | Township Number 23 S | Range Number R 1 E |
|---|----------------------------|----------------------|-------------------------|-----------------------|

Distance and direction from nearest town or city street address of well if located within city?
Well was located at 320 N. Main , Newton KS 67114

| | |
|---|---|
| 2 WATER WELL OWNER: Dillions #6 RR#, St. Address, Box #: 320 N. Main City, State ZIP Code: Newton, KS 67114 | Global Positioning Systems (decimal degrees, min. of 4 digits) Latitude: _____ Longitude: _____ Elevation: _____ Datum: _____ Data Collection Method: _____ |
|---|---|

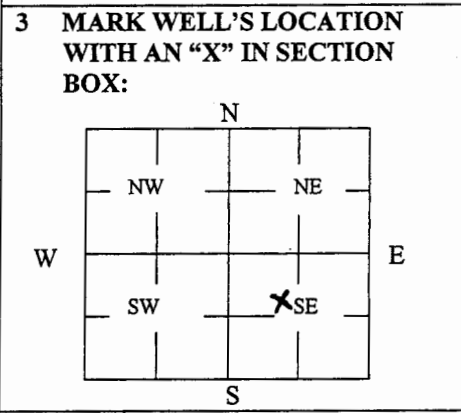

4 DEPTH OF WELL 13.45 ft.
WELL'S STATIC WATER LEVEL 6.65 ft
WELL WAS USED AS:
1 Domestic 5 Public Water Supply 9 Dewatering
2 Irrigation 6 Oil Field Water Supply 10 Monitoring
3 Feedlot 7 Domestic (Lawn & Garden) 11 Injection Well
4 Industrial 8 Air Conditioning 12 Other _____
Was a chemical/bacteriological sample submitted to Department? Yes _____ No x _____

5 TYPE OF BLANK CASING USED:
1 Steel 3 RMP (SR) 5 Wrought 7 Fiberglass 9 Other (Specify below)
2 PVC 4 ABS 6 Asbestos-Cement 8 Concrete Tile
Blank casing diameter 2 in. Was casing pulled? Yes X No _____ If yes, how much 3 ft.
Casing height above or below land surface _____ in.

6 GROUT PLUG MATERIAL: 1 Neat cement 2 Cement grout 3 Bentonite 4 Other Concrete
Grout Plug Intervals: 4 From 0 ft. to .5 ft., 3 From .5 ft. to 13.45 ft., From _____ to _____ ft.
What is the nearest source of possible contamination:
1 Septic tank 6 Seepage pit 11 Fuel Storage 16 Other (specify below) Contaminated site
2 Sewer lines 7 Pit privy 12 Fertilizer storage
3 Watertight sewer lines 8 Sewage lagoon 13 Insecticide storage
4 Lateral lines 9 Feedyard 14 Abandoned water well Direction from well? _____
5 Cess pool 10 Livestock pens 15 Oil well/Gas well How many feet? _____

| FROM | TO | PLUGGING MATERIALS | FROM | TO | PLUGGING MATERIALS |
|------|-------|--------------------|------|----|--------------------|
| 0' | .5 | Concrete | | | |
| .5 | 13.45 | Bentonite Chips | | | |
| | | | | | |
| | | | | | |
| | | | | | |

7 CONTRACTOR'S OR LANDOWNER'S CERTIFICATION: This water well was plugged under my jurisdiction and was completed on (mo/day/year) 12/22/2009 and this record is true to the best of my knowledge and belief. Kansas Water Well Contractor's License No. 585. This Water Well Record was completed on (mo/day/year) 1/6/2010 under the business name of Associated Environmental, Inc. by (signature) [Signature]

INSTRUCTIONS: Use typewriter or ballpoint pen. Please press firmly and print clearly. Please fill in blanks, underline or circle the correct answers. Send top three copies to Kansas Department of Health and Environment, Bureau of Water, Geology Section, 1000 SW Jackson St., Ste. 420, Topeka, Kansas 66612-1367. Telephone: 785/296-5522. Send one to Water Well Owner and retain one for your records. Visit us at <http://www.kdheks.gov/waterwell/index.html>.