


<b>1 LOCATION OF WATER WELL:</b> County: <b>Harvey</b>	Fraction <b>SW ¼ NW ¼ SE ¼</b>	Section Number <b>8</b>	Township Number <b>23S</b>	Range Number <b>1</b>
---	-----------------------------------	----------------------------	-------------------------------	--------------------------

Distance and direction from nearest town or city street address of well if located within city?  
**1700 N. Main - Newton**

<b>2 WATER WELL OWNER: KDHE</b>  RR#, St. Address, Box #: <b>1000 SW Jackson St., Ste. 410</b>  City, State, ZIP Code: <b>Topeka, KS 66612</b>	<b>Global Positioning System</b> (decimal degrees, min. of 4 digits) Latitude: _____ Longitude: _____ Elevation: _____ Datum: _____ Data Collection Method: _____
--	--

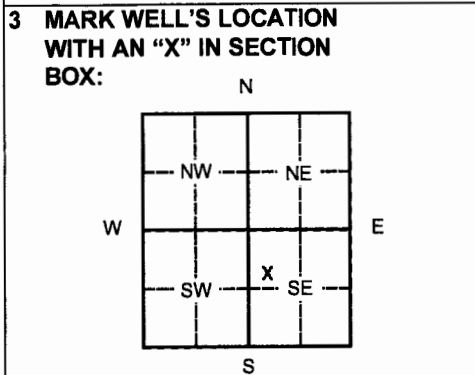

**4 DEPTH OF WELL** Unknown\* ft.

WELL'S STATIC WATER LEVEL Unknown\* ft

WELL WAS USED AS:

1 Domestic	5 Public Water Supply	9 Dewatering
2 Irrigation	6 Oil Field Water Supply	10 <b>Monitoring</b>
3 Feedlot	7 Domestic (Lawn & Garden)	11 Injection Well
4 Industrial	8 Air Conditioning	12 Other _____

Was a chemical/bacteriological sample submitted to Department? Yes \_\_\_ No X

**5 TYPE OF BLANK CASING USED:**

1 Steel	3 RMP (SR)	5 Wrought	7 Fiberglass	9 Other (Specify below)
2 <b>PVC</b>	4 ABS	6 Asbestos-Cement	8 Concrete Tile	_____

Blank casing diameter 1 in. Was casing pulled? Yes X No \_\_\_ If yes, how much 2 ft  
Casing height above or below land surface 24 in.

**6 GROUT PLUG MATERIAL:** 1 Neat cement 2 Cement grout 3 Bentonite 4 Other \_\_\_\_\_

Grout Plug Intervals: From NA\* ft. to \_\_\_\_\_ ft., From \_\_\_\_\_ ft. to \_\_\_\_\_ ft., From \_\_\_\_\_ to \_\_\_\_\_ ft.

What is the nearest source of possible contamination:

1 Septic tank	6 Seepage pit	11 Fuel Storage	16 Other (specify below)
2 Sewer lines	7 Pit privy	12 Fertilizer storage	_____
3 Watertight sewer lines	8 Sewage lagoon	13 Insecticide storage	
4 Lateral lines	9 Feedyard	14 Abandoned water well	Direction from well?
5 Cess pool	10 Livestock pens	15 Oil well/Gas well	How many feet?

FROM	TO	PLUGGING MATERIALS	FROM	TO	PLUGGING MATERIALS
0	2	Native Soil			
2	?*	Well obstructed with dirt/debris at 2 ft.			

**7 CONTRACTOR'S OR LANDOWNER'S CERTIFICATION:** This water well was plugged under my jurisdiction and was completed on (mo/day/year) 02/13/13 and this record is true to the best of my knowledge and belief. Kansas Water Well Contractor's License No. 531. This Water Well Record was completed on (mo/day/year) 03/18/13 under the business name of GSI Engineering, LLC by (signature) [Signature]

**INSTRUCTIONS:** Please fill in blanks or circle the correct answers. Send top three copies to Kansas Department of Health and Environment, Bureau of Water, Geology Section, 1000 SW Jackson St., Ste. 420, Topeka, Kansas 66612-1367. Telephone: 785/296-5522. Send one to Water Well Owner and retain one for your records. Visit us at <http://www.kdheks.gov/waterwell>.