

**WATER WELL PLUGGING RECORD Form WWC-5P**

KSA 82a-1212 ID NO.

MW-10

<b>1 LOCATION OF WATER WELL:</b> County: <u>Harvey</u>	Fraction <u>NW 1/4 SE 1/4 NE 1/4 SW 1/4</u>	Section Number <u>17</u>	Township Number <u>T 23 S</u>	Range Number <u>1</u> <input checked="" type="checkbox"/> E <input type="checkbox"/> W
---	--	-----------------------------	----------------------------------	---

Street/Rural Address of Well Location; if unknown, distance & direction from nearest town or intersection: If at owner's address, check here  132 W. 5th St. Newton, KS 67114

**Global Positioning Systems (GPS) information:**  
 Latitude: 38.04761 (in decimal degrees)  
 Longitude: 97.34762 (in decimal degrees)  
 Elevation: 1438.52  
 Horizontal Datum:  WGS84,  NAD83,  NAD27  
 Collection Method:

**2 WATER WELL OWNER:** Holstine Motors  
 RR#, St. Address, Box #: 132 W. 5th St.  
 City, State ZIP Code: Newton, KS 67114

GPS unit (Make/Model: \_\_\_\_\_)  
 Digital Map/Photo,  Topographic Map,  Land Survey  
 Est. Accuracy:  < 3 m,  3-5 m,  5-15 m,  > 15 m

**3 MARK WELL'S LOCATION WITH AN "X" IN SECTION BOX:**

**4 DEPTH OF WELL** 15.08 ft.  
 WELL'S STATIC WATER LEVEL 8.73 ft  
 WELL WAS USED AS:  
 Domestic  Public Water Supply  Dewatering  
 Irrigation  Oil Field Water Supply  Monitoring  
 Feedlot  Domestic (Lawn & Garden)  Injection Well  
 Industrial  Air Conditioning  Other \_\_\_\_\_  
 Was a chemical/bacteriological sample submitted to Department? Yes  No

**5 TYPE OF BLANK CASING USED:**

Steel  RMP (SR)  Wrought  Fiberglass  Other (Specify below)  
 PVC  ABS  Asbestos-Cement  Concrete Tile \_\_\_\_\_

Blank casing diameter 2 in. Was casing pulled? Yes  No  If yes, how much 3 ft  
 Casing height above or below land surface 36 in.

**6 GROUT PLUG MATERIAL:**  Neat cement  Cement grout  Bentonite  Other \_\_\_\_\_

Grout Plug Intervals: From 3 ft. to 15.08 ft., From \_\_\_\_\_ ft. to \_\_\_\_\_ ft., From \_\_\_\_\_ ft. to \_\_\_\_\_ ft.

What is the nearest source of possible contamination:  
 Septic tank  Seepage pit  Fuel storage  Other (specify below)  
 Sewer lines  Pit privy  Fertilizer storage \_\_\_\_\_  
 Watertight sewer lines  Sewage lagoon  Insecticide storage \_\_\_\_\_  
 Lateral lines  Feedyard  Abandoned water well  Direction from well? South  
 Cess pool  Livestock pens  Oil well/Gas well  How many feet? 25







FROM	TO	PLUGGING MATERIALS	FROM	TO	PLUGGING MATERIALS
0	0.5	Asphalt			
0.5	3	Compacted silt/clay			
3	15.08	Hydrated bentonite chips			

**7 CONTRACTOR'S OR LANDOWNER'S CERTIFICATION:** This water well was plugged under my jurisdiction and was completed on (mo/day/year) 8/1/18 and this record is true to the best of my knowledge and belief. Kansas Water Well Contractor's License No. 585. This Water Well Record was completed on (mo/day/year) 8/20/18 under the business name of Associated Environmental, Inc. by (signature) [Signature]


Send one white copy to Kansas Department of Health & Environment, Geology Section, 1000 SW Jackson Street, Ste. 420, Topeka, KS 66612-1367. Send one copy to WATER WELL OWNER and retain one for your records.  
 Visit us at <http://www.kdheks.gov/waterwell/index.html> Telephone 785-296-5524.



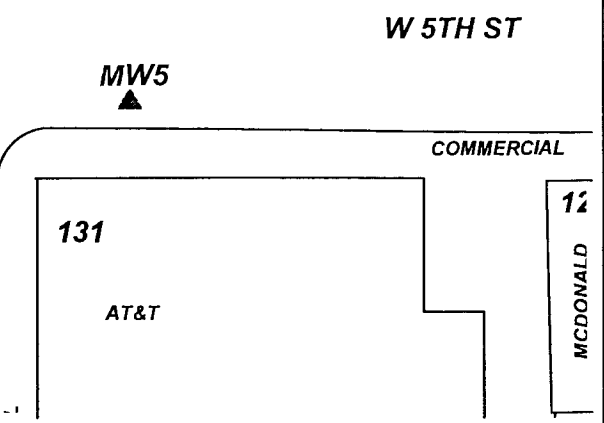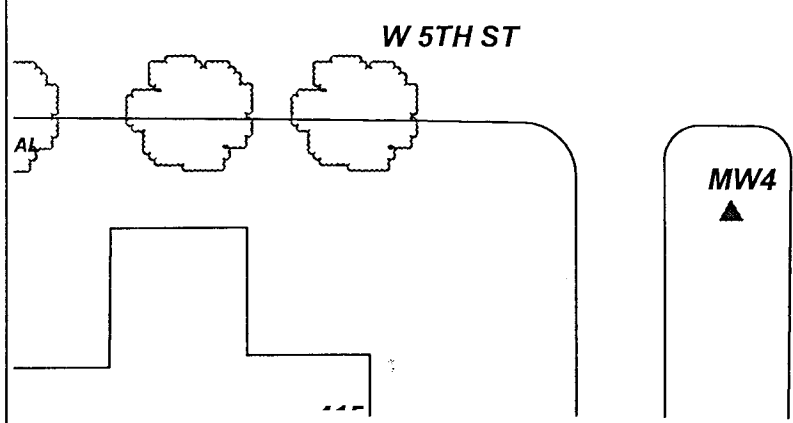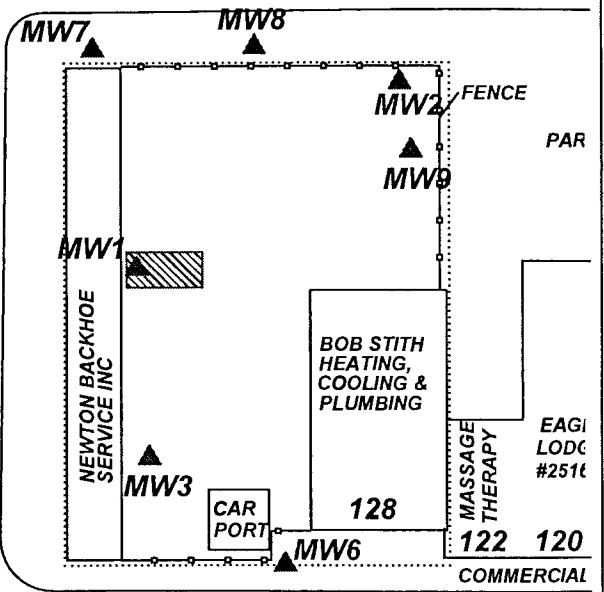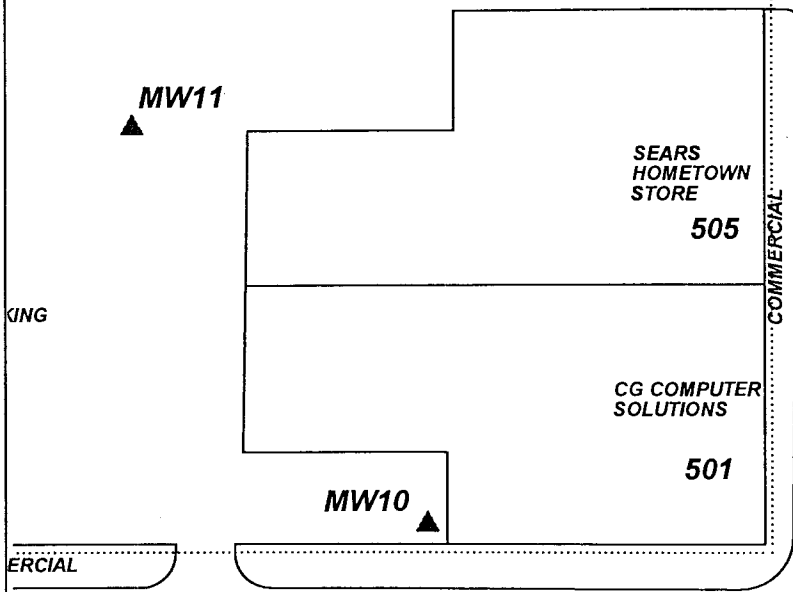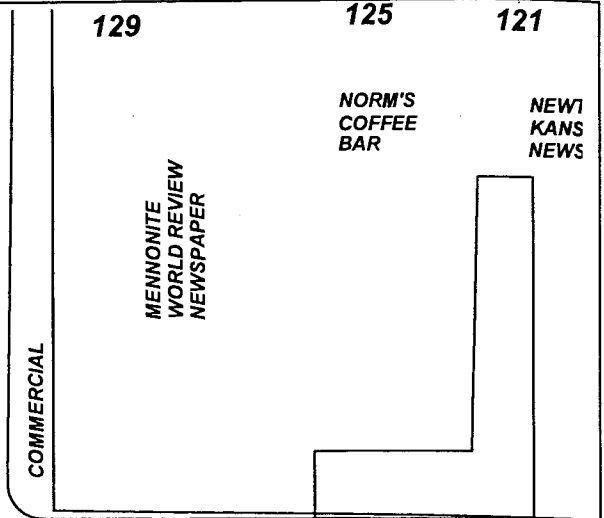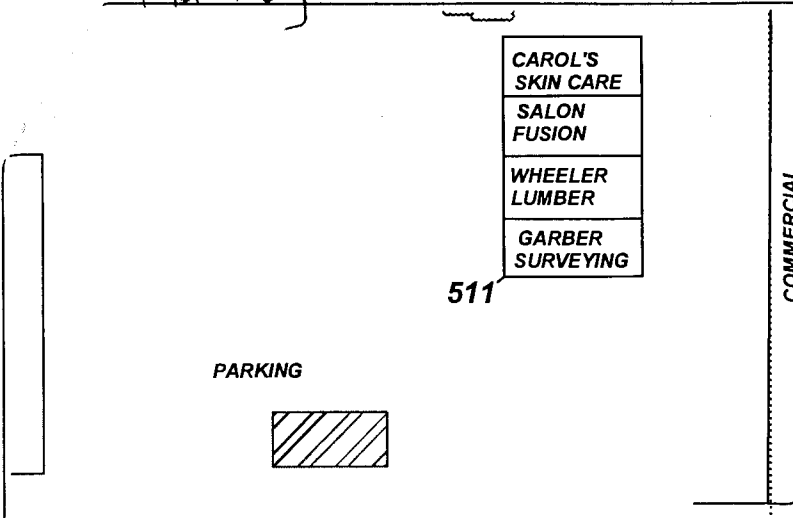

KSA82a-1212 Revised 1/20/2015


Harvey 17-23-1



PROJECT: **HOLSTINE MOTORS**  
 ADDRESS: **132 W. 5TH ST.**  
 LOCATION: **NEWTON, KS**  
 DRAWN BY: **B. STALNAKER** DATE: **9/16/16**  
 REVISED BY: **C. ROE** DATE: **4/13/18**  
 AEI JOB #: **TF141** KDHE JOB #: **U2-040-00759**

TITLE:  
 **ASSOCIATED ENVIRONMENTAL INC.**

LEGEND:  
 = FORMER UST'S: 1-1000 GAL GASOLINE 1-750 GAL WASTE OIL  
 = FORMER 750 GAL GASOLINE UST  
 = MONITOR WELL  
 = PLUGGED/DESTROYED WELL  
 ..... = SUBJECT PROPERTY

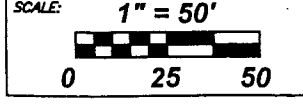

NOTES: