

WATER WELL PLUGGING RECORD Form WWC-5P KSA 82a-1212 ID NO.
MW1

1 LOCATION OF WATER WELL: County: HARVEY	Fraction NW ¼ NW¼ NW ¼ ¼	Section Number 21	Township Number T 23 S	Range Number 1 <input checked="" type="checkbox"/> E <input type="checkbox"/> W
---	------------------------------------	-----------------------------	----------------------------------	---

Street/Rural Address of Well Location; if unknown, distance & direction from nearest town or intersection: If at owner's address, check here ☒

Global Positioning Systems (GPS) information:

Latitude: **38.041816** (in decimal degrees)

Longitude: **-97.335077** (in decimal degrees)

Elevation: **1447.44**


Horizontal Datum: ☐ WGS84, ☒ NAD83, ☐ NAD27

Collection Method:

☐ GPS unit (Make/Model: _____)

☐ Digital Map/Photo, ☐ Topographic Map, ☒ Land Survey

Est. Accuracy: ☐ < 3 m, ☐ 3-5 m, ☐ 5-15 m, ☐ > 15 m

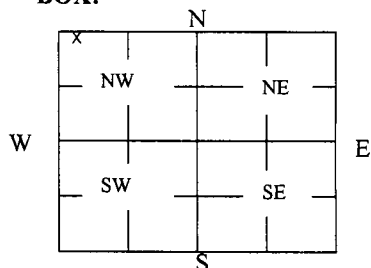3 MARK WELL'S LOCATION WITH AN "X" IN SECTION BOX:

4 DEPTH OF WELL 13.26 ft.

WELL'S STATIC WATER LEVEL 6.04 ft

WELL WAS USED AS:

☐ Domestic
☐ Irrigation
☐ Feedlot
☐ Industrial

☐ Public Water Supply
☐ Oil Field Water Supply
☐ Domestic (Lawn & Garden)
☐ Air Conditioning

☐ Dewatering
☒ Monitoring
☐ Injection Well
☐ Other _____

Was a chemical/bacteriological sample submitted to Department? Yes ☐ No ☐

5 TYPE OF BLANK CASING USED:

☐ Steel
☒ PVC

☐ RMP (SR)
☐ ABS

☐ Wrought
☐ Asbestos-Cement

☐ Fiberglass
☐ Concrete Tile

☐ Other (Specify below) _____

Blank casing diameter 2 in. Was casing pulled? Yes ☒ No ☐ If yes, how much 3'
Casing height above or below land surface _____ in.

6 GROUT PLUG MATERIAL: ☐ Neat cement ☐ Cement grout ☒ Bentonite ☐ Other _____

Grout Plug Intervals: From 3 ft. to 13.26 ft., From _____ ft. to _____ ft., From _____ ft. to _____ ft.

What is the nearest source of possible contamination:

☐ Septic tank
☐ Sewer lines
☐ Watertight sewer lines
☐ Lateral lines
☐ Cess pool

☐ Seepage pit
☐ Pit privy
☐ Sewage lagoon
☐ Feedyard
☐ Livestock pens

☒ Fuel storage
☐ Fertilizer storage
☐ Insecticide storage
☐ Abandoned water well
☐ Oil well/Gas well

☐ Other (specify below) _____

Direction from well? _____
How many feet? 0

FROM	TO	PLUGGING MATERIALS	FROM	TO	PLUGGING MATERIALS
0	3	SOIL			
3	13.26	BENTONITE			

7 CONTRACTOR'S OR LANDOWNER'S CERTIFICATION: This water well was plugged under my jurisdiction and was completed on (mo/day/year) 11/5/19 and this record is true to the best of my knowledge and belief. Kansas Water Well Contractor's License No. 585. This Water Well Record was completed on (mo/day/year) 11/11/19 under the business name of Associated Environmental, Inc. by (signature) _____

Send one white copy to Kansas Department of Health & Environment, Geology Section, 1000 SW Jackson Street, Ste. 420, Topeka, KS 66612-1367. Send one copy to WATER WELL OWNER and retain one for your records.


Visit us at <http://www.kdheks.gov/waterwell/index.html> Telephone 785-296-5524.

DEC 10 2019

KSA82a-1212

Revised 1/20/2015

BUREAU OF WATER

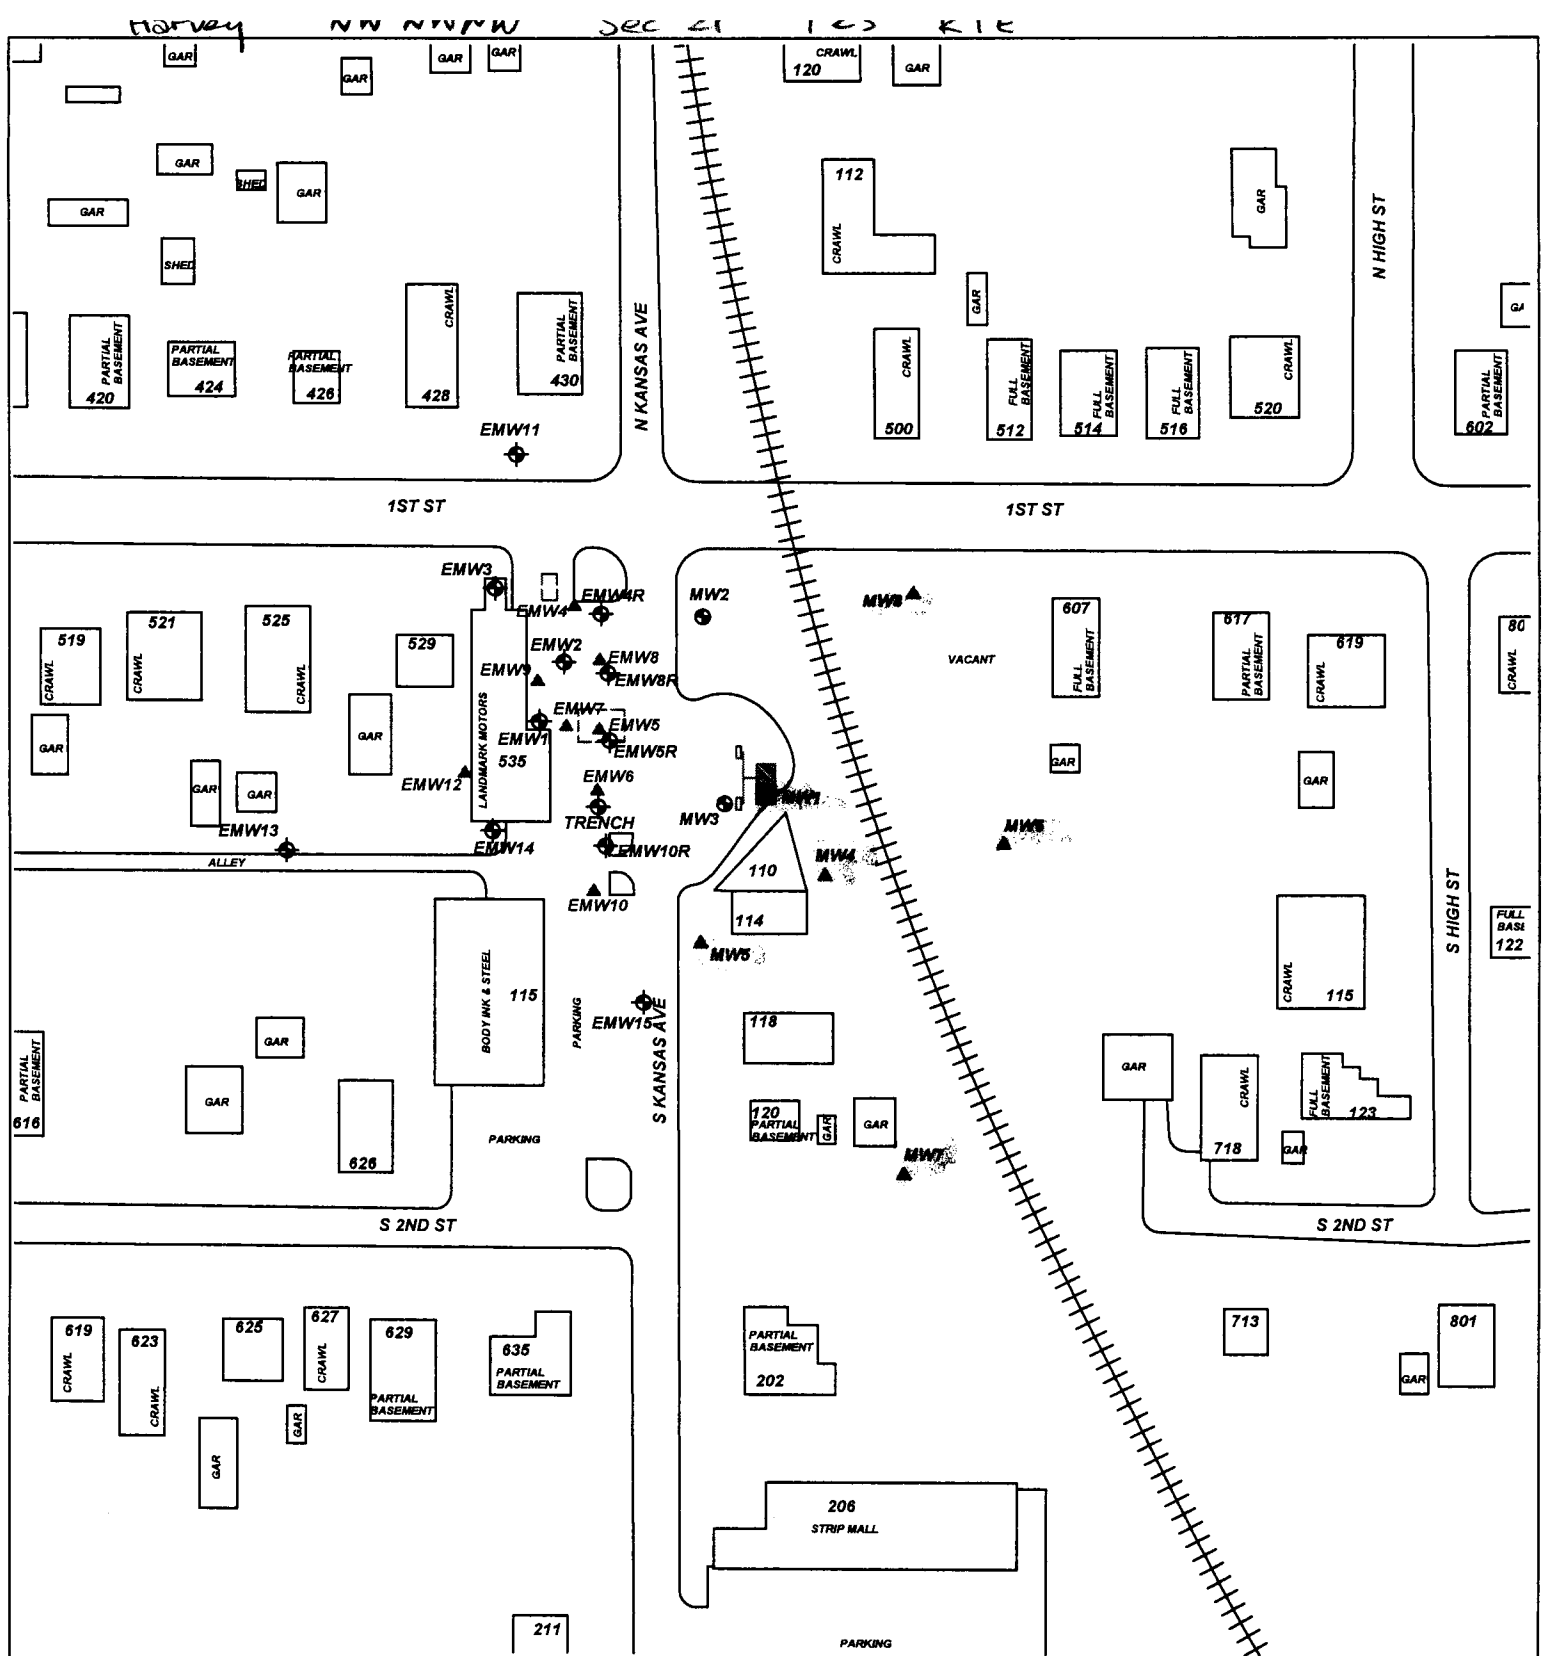

PROJECT: **KEMP, LOWELL**

ADDRESS: **110 S. KANSAS AVE.**

LOCATION: **NEWTON, KS**

DRAWN BY: **B. STALNAKER** DATE: **1/9/18**

REVISED BY: **B. STALNAKER** DATE: **5/10/19**

AEI JOB #: **TF117** KDHE JOB #: **U2-040-01077**

TITLE:



**ASSOCIATED
ENVIRONMENTAL
INC.**

LEGEND:

- = FORMER 2000 GALLON UST AND ISLANDS
- = FORMER FINA SITE UST BASIN
- = MONITOR WELL
- = FINA SITE MONITOR WELLS
- = PLUGGED/DESTROYED WELL

..... = SUBJECT PROPERTY

SCALE: **1" = 100'**



0 50 100

NOTES: