


## MW14

Well ID

Revised 7/10/2015

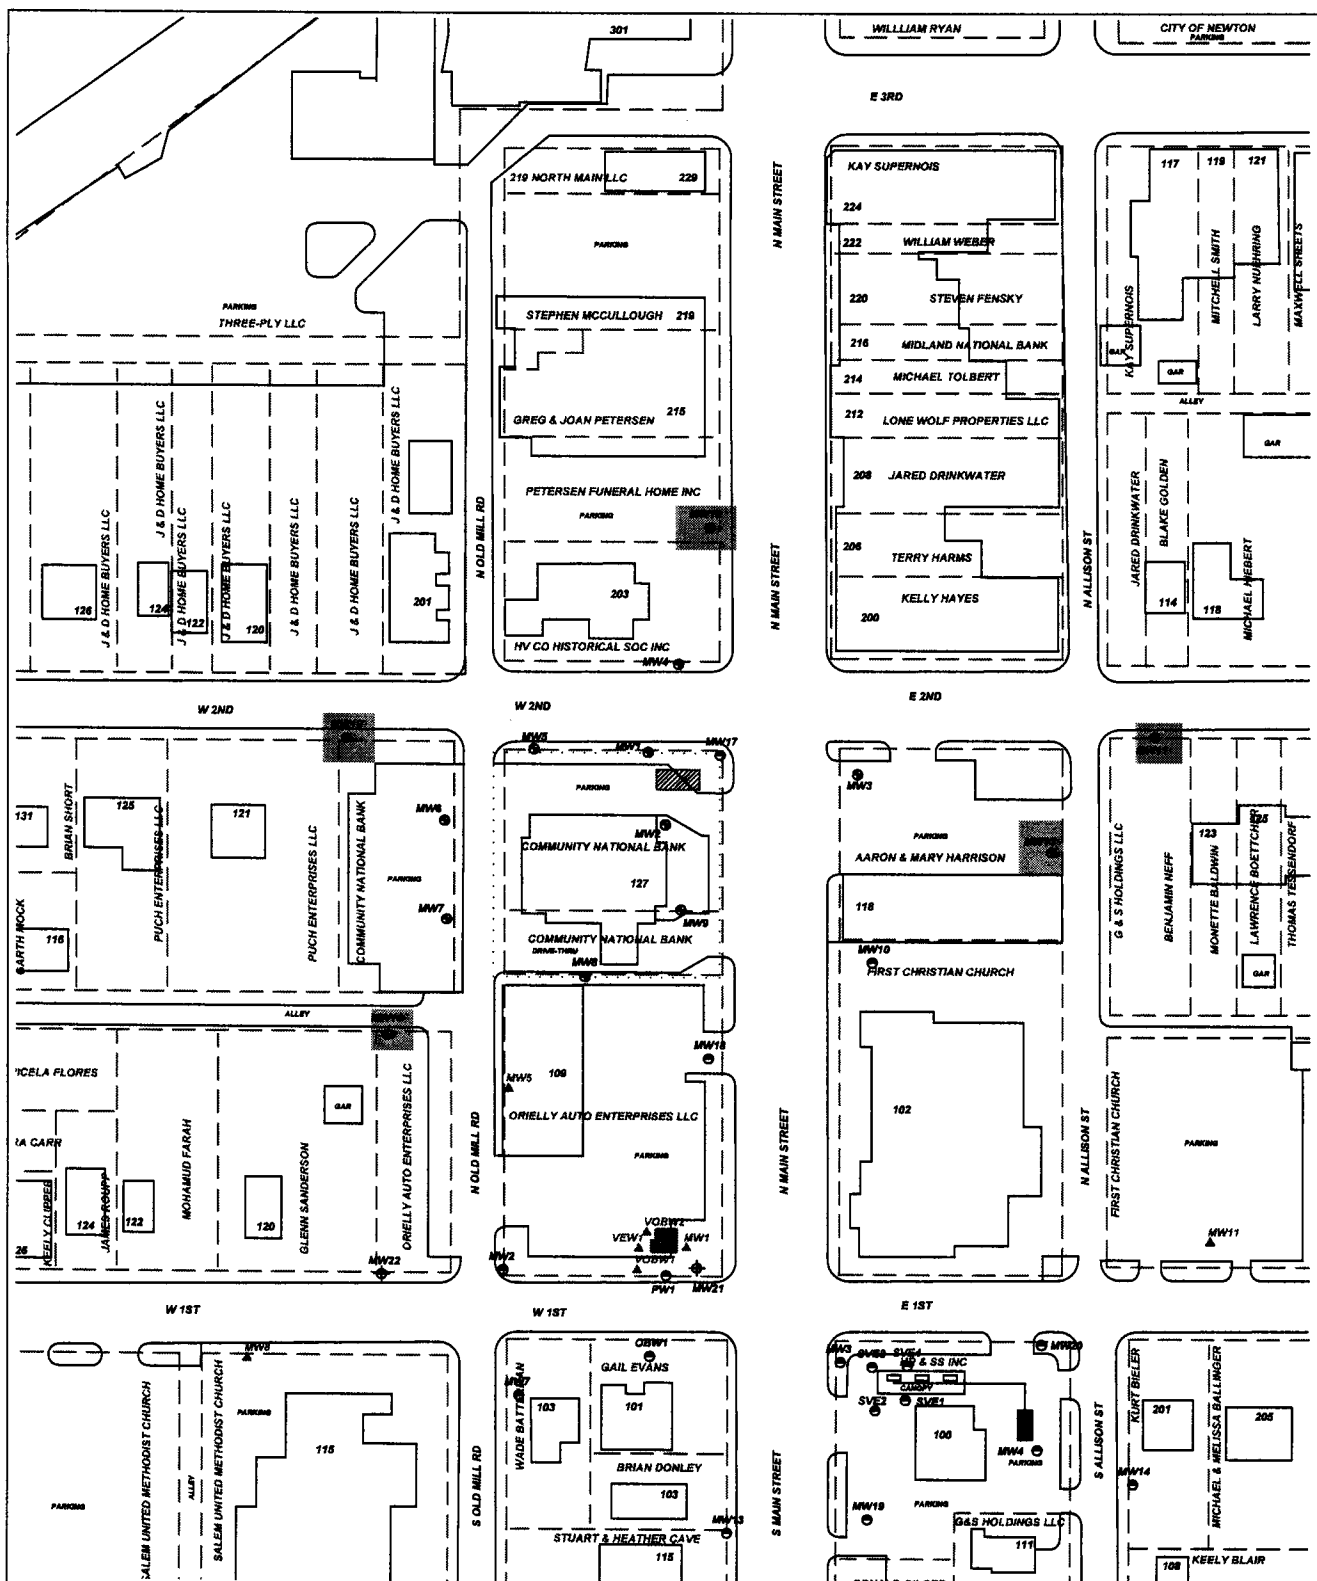

PROJECT: **FORMER SINCLAIR, NEWTON**

ADDRESS: **127 N. MAIN STREET**

LOCATION: **NEWTON, KS**

DRAWN BY: **B. STALNAKER** DATE: **4/15/19**

REVISED BY: **C. ROE** DATE: **11/15/19**

AEI JOB #: **TM245** KDCI JOB #: **U2-040-15031**

TITLE: **FIGURE 2.2  
AREA BASE MAP  
500' RADIUS**

**ASSOCIATED  
ENVIRONMENTAL  
INC.**

LEGEND:

- = FORMER UST BASIN/EXCAVATION
- = CURRENT UST'S AND PUMP ISLANDS
- = MONITORING WELL
- = PRIME TIME STORE #125(U2-040-00441)
- = PLUGGED/DESTROYED WELL
- = PROPOSED MONITORING WELL
- = SUBJECT PROPERTY
- = PARCEL BOUNDARY

SCALE: **1" = 100'**

NOTES:  
No basements observed within 500'.