


WATER WELL RECORD Form WWC-5

[X] Original Record [ ] Correction [ ] Change in Well Use

Division of Water Resources App. No. [ ] Well ID [ ]

1 LOCATION OF WATER WELL: County: Sedgwick Fraction NW 1/4 SW 1/4 SW 1/4 SW 1/4 Section Number 23 Township Number T 28 S Range Number R 1 [X] E [ ] W

2 WELL OWNER: Last Name: BAKER First: Jimmie Street or Rural Address where well is located (if unknown, distance and direction from nearest town or intersection): If at owner's address, check here: [X] Business: Address: 3201 E. Shoffner Ct. City: Wichita State: Kansas ZIP: 67216

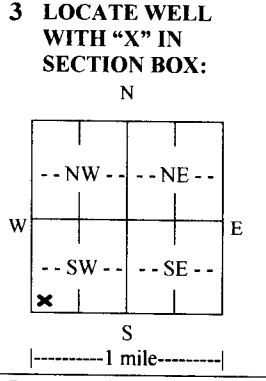

3 LOCATE WELL WITH 'X' IN SECTION BOX: N W E S [X] 4 DEPTH OF COMPLETED WELL: 40 ft. Depth(s) Groundwater Encountered: 1) ... ft. 2) ... ft. 3) ... ft., or 4) [ ] Dry Well WELL'S STATIC WATER LEVEL: 1.4 ft. [X] below land surface, measured on (mo-day-yr) 10/05/22. [ ] above land surface, measured on (mo-day-yr) ... Pump test data: Well water was ... ft. after ... hours pumping ... gpm Well water was ... ft. after ... hours pumping ... gpm Estimated Yield: ... gpm Bore Hole Diameter: 1.2 in. to 4.0 ft. and ... in. to ... ft.

5 Latitude: 37.59291 (decimal degrees) Longitude: -97.29850 (decimal degrees) Horizontal Datum: [X] WGS 84 [ ] NAD 83 [ ] NAD 27 Source for Latitude/Longitude: [X] GPS (unit make/model: iPhone) (WAAS enabled? [ ] Yes [ ] No) [ ] Land Survey [ ] Topographic Map [ ] Online Mapper: ...

6 Elevation: ... ft. [ ] Ground Level [ ] TOC Source: [ ] Land Survey [X] GPS [ ] Topographic Map [ ] Other ...

7 WELL WATER TO BE USED AS: 1. Domestic: [ ] Household [X] Lawn & Garden [ ] Livestock 2. [ ] Irrigation 3. [ ] Feedlot 4. [ ] Industrial 5. [ ] Public Water Supply: well ID ... 6. [ ] Dewatering: how many wells? ... 7. [ ] Aquifer Recharge: well ID ... 8. [ ] Monitoring: well ID ... 9. Environmental Remediation: well ID ... [ ] Air Sparge [ ] Soil Vapor Extraction [ ] Recovery [ ] Injection 10. [ ] Oil Field Water Supply: lease ... 11. Test Hole: well ID ... [ ] Cased [ ] Uncased [ ] Geotechnical 12. Geothermal: how many bores? ... a) Closed Loop [ ] Horizontal [ ] Vertical b) Open Loop [ ] Surface Discharge [ ] Inj. of Water 13. [ ] Other (specify): ...

Was a chemical/bacteriological sample submitted to KDHE? [ ] Yes [X] No If yes, date sample was submitted: ... Water well disinfected? [X] Yes [ ] No

8 TYPE OF CASING USED: [ ] Steel [X] PVC [ ] Other CASING JOINTS: [X] Glued [ ] Clamped [ ] Welded [ ] Threaded Casing diameter .5 in. to 4.0 ft., Diameter ... in. to ... ft., Diameter ... in. to ... ft. Casing height above land surface 1.2 in. Weight 2.35 lbs./ft. Wall thickness or gauge No. SDR-26

TYPE OF SCREEN OR PERFORATION MATERIAL: [ ] Steel [ ] Stainless Steel [ ] Fiberglass [X] PVC [ ] Brass [ ] Galvanized Steel [ ] Concrete tile [ ] None used (open hole) [ ] Other (Specify) ...

SCREEN OR PERFORATION OPENINGS ARE: [ ] Continuous Slot [ ] Mill Slot [ ] Gauze Wrapped [ ] Torch Cut [ ] Drilled Holes [ ] Other (Specify) ... [ ] Louvered Shutter [ ] Key Punched [ ] Wire Wrapped [X] Saw Cut [ ] None (Open Hole)

SCREEN-PERFORATED INTERVALS: From 30 ft. to 40 ft., From ... ft. to ... ft., From ... ft. to ... ft. GRAVEL PACK INTERVALS: From 24 ft. to 40 ft., From ... ft. to ... ft., From ... ft. to ... ft.

9 GROUT MATERIAL: [ ] Neat cement [ ] Cement grout [X] Bentonite [ ] Other Grout Intervals: From .4 ft. to .24 ft., From ... ft. to ... ft., From ... ft. to ... ft.

Nearest source of possible contamination: [ ] Septic Tank [ ] Lateral Lines [ ] Pit Privy [ ] Livestock Pens [ ] Insecticide Storage [ ] Sewer Lines [ ] Cess Pool [ ] Sewage Lagoon [ ] Fuel Storage [ ] Abandoned Water Well [X] Watertight Sewer Lines [ ] Seepage Pit [ ] Feedyard [ ] Fertilizer Storage [ ] Oil Well/Gas Well [ ] Other (Specify) ...

Direction from well? South Distance from well? 15 ft. plus

Table with columns: FROM, TO, LITHOLOGIC LOG, FROM, TO, LITHO. LOG (cont.) or PLUGGING INTERVALS. Rows: 0-3 topsoil, 3-10 clay, 10-18 fine sand, 18-35 medium sand, 35-40 gray shale. Includes a Notes section.

11 CONTRACTOR'S OR LANDOWNER'S CERTIFICATION: This water well was [X] constructed, [ ] reconstructed, or [ ] plugged under my jurisdiction and was completed on (mo-day-year) 10/05/2022. and this record is true to the best of my knowledge and belief. Kansas Water Well Contractor's License No. 236 This Water Well Record was completed on (mo-day-year) 10/17/2022. under the business name of Harp Well and Pump Service Signature Todd S. Harp