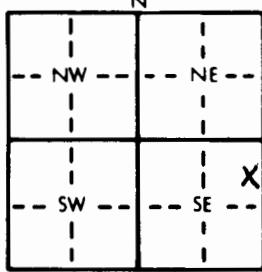


1 LOCATION OF WATER WELL: Fraction $\frac{1}{4}$ NE $\frac{1}{4}$ SE $\frac{1}{4}$ Section Number 17 Township Number T 23 S Range Number R 1 EW
 County: HARVEY

Distance and direction from nearest town or city street address of well if located within city? Just west of main line UPRR between North/South Portion of Kansas Street & between 5th & 6th streets. Newton KS.

2 WATER WELL OWNER: USPCI/UPRR
 RR#, St. Address, Box #: 5665 Flatiron PKWY Board of Agriculture, Division of Water Resources
 City, State, ZIP Code: Boulder CO 80301 Application Number:

3 LOCATE WELL'S LOCATION WITH AN "X" IN SECTION BOX:  DEPTH OF COMPLETED WELL: 12.5 ft. ELEVATION: 1456.48'
 Depth(s) Groundwater Encountered 1. ft. 2. ft. 3. ft.
 WELL'S STATIC WATER LEVEL: 4.8 ft. below land surface measured on mo/day/yr 6/15/92
 Pump test data: Well water was ft. after hours pumping gpm
 Est. Yield gpm: Well water was ft. after hours pumping gpm
 Bore Hole Diameter: 7 in. to 12.5 ft., and in. to ft.
 WELL WATER TO BE USED AS: 5 Public water supply 8 Air conditioning 11 Injection well
 1 Domestic 3 Feedlot 6 Oil field water supply 9 Dewatering 12 Other (Specify below)
 2 Irrigation 4 Industrial 7 Lawn and garden only 10 Monitoring well MW-6
 Was a chemical/bacteriological sample submitted to Department? Yes No; If yes, mo/day/yr sample was submitted
 Water Well Disinfected? Yes No

5 TYPE OF BLANK CASING USED: 1 Steel 2 PVC 3 RMP (SR) 4 ABS 5 Wrought iron 6 Asbestos-Cement 7 Fiberglass 8 Concrete tile 9 Other (specify below) CASING JOINTS: Glued Clamped
 Blank casing diameter: 2 in. to 2.5 ft., Dia in. to ft., Dia in. to ft.
 Casing height above land surface: ~30 in., weight lbs./ft. Wall thickness or gauge No.
 TYPE OF SCREEN OR PERFORATION MATERIAL: 1 Steel 2 Brass 3 Stainless steel 4 Galvanized steel 5 Fiberglass 6 Concrete tile 7 PVC 8 RMP (SR) 9 ABS 10 Asbestos-cement 11 Other (specify) 12 None used (open hole)
 SCREEN OR PERFORATION OPENINGS ARE: 1 Continuous slot 2 Louvered shutter 3 Mill slot 4 Key punched 5 Gauzed wrapped 6 Wire wrapped 7 Torch cut 8 Saw cut 9 Drilled holes 10 Other (specify) 11 None (open hole)
 SCREEN-PERFORATED INTERVALS: From 2.5 ft. to 12.5 ft., From ft. to ft.
 GRAVEL PACK INTERVALS: From 1.5 ft. to 13.0 + 2.5 ft., From ft. to ft.

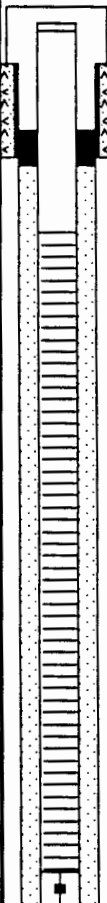
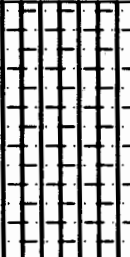
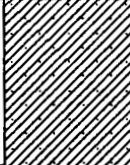

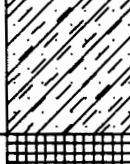
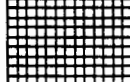
6 GROUT MATERIAL: 1 Neat cement 2 Cement grout 3 Bentonite 4 Other
 Grout Intervals: From 1.0 ft. to 1.5 ft., From ft. to ft., From ft. to ft.
 What is the nearest source of possible contamination: 1 Septic tank 2 Sewer lines 3 Watertight sewer lines 4 Lateral lines 5 Cess pool 6 Seepage pit 7 Pit privy 8 Sewage lagoon 9 Feedyard 10 Livestock pens 11 Fuel storage 12 Fertilizer storage 13 Insecticide storage 14 Abandoned water well 15 Oil well/Gas well 16 Other (specify below) UNKNOWN

FROM	TO	LITHOLOGIC LOG	FROM	TO	PLUGGING INTERVALS
		See attached well log NKW-6 from time well drilled and completed	0.0	3.0	native soil
			3.0	12.5	sodium bentonite pellets

7 CONTRACTOR'S OR LANDOWNER'S CERTIFICATION: This water well was (1) constructed, (2) reconstructed, or (3) plugged under my jurisdiction and was completed on (mo/day/year) Feb 16, 1994 and this record is true to the best of my knowledge and belief. Kansas Water Well Contractor's License No. This Water Well Record was completed on (mo/day/yr) 7/11/94 under the business name of by (signature) David G. Earnshaw

Remedial Services

CLIENT: Union Pacific Railroad			JOB NUMBER: 98120 (058)		
PROJECT: Newton Leaking UST			LOCATION: Newton, Kansas		
DRILLED BY: Fugro Geoscience		DRILLER: Jumbo Vogt		METHOD: 7" HSA	
DATE START: 8-15-92		DATE COMP: 8-15-92		SURF. EL:1456.48'	TD: 13.0'
LOGGED BY: Bruce Zuccaro			DEPTH TO WATER: 1.8'		

WELL COMP	DPT	DESCRIPTION	GRAPHIC LOG USCS CODE	BLOW COUNT	OVM	SAMPLE NUMBER	TOC
	0	0.0' - 3.9' Fill, Clay; sft, sl ptc, inorg., abdt Sand, v cs grn, ocs Gravel, sbrd; v moist, wet blw 1.8'			0.0		
			AF		0.0		
	5	3.9' - 6.4' CLAY; med bn, clean, v sft, ptc, inorg, ocs Sand, med grn, sl perm; wet			0.0		
			CH		0.0		
		6.4' - 8.1' CLAY; med bn, clean, sft, ptc, inorg, ocs Sand, carb, cs grn; wet					
		OH					
	10	8.1' - 11.1' CLAY; v dk-v lt bn, clean, sft-fm, ptc, sl org, sl perm, rr Sand, carb, v f grn; wet					
			Sh				
		11.1' - 13.0' SHALE (bedrock); lt-dk bu-gn, clean, carb, v fm, sl perm; wet					
	15	Total Depth = 13.0'					
	20						

NEW8-8
NEW8-18
(dup)