


1 LOCATION OF WATER WELL: Fraction NE 1/4 NE 1/4 SW 1/4 Section Number 17 Township Number T 23 S Range Number R 1E EW  
 County: HARVEY

Distance and direction from nearest town or city street address of well if located within city?  
132 W 5TH ST - NEWTON

2 WATER WELL OWNER: HOLSTINE MOTORS  
 RR#, St. Address, Box # 132 W 5TH ST. NEWTON-KS 67114 Board of Agriculture, Division of Water Resources  
 City, State, ZIP Code Application Number:

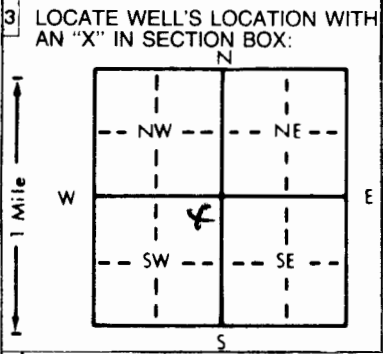

4 DEPTH OF COMPLETED WELL 15 ft. ELEVATION:  
 Depth(s) Groundwater Encountered 1. 10 ft. 2. - ft. 3. - ft.  
 WELL'S STATIC WATER LEVEL 10.07 ft. below land surface measured on mo/day/yr 08-16-94  
 Pump test data: Well water was - ft. after - hours pumping - gpm  
 Est. Yield - gpm: Well water was - ft. after - hours pumping - gpm  
 Bore Hole Diameter 8.625 in. to 15 ft. and - in. to - ft.  
 WELL WATER TO BE USED AS: 5 Public water supply 8 Air conditioning 11 Injection well  
 1 Domestic 3 Feedlot 6 Oil field water supply 9 Dewatering 12 Other (Specify below)  
 2 Irrigation 4 Industrial 7 Lawn and garden only 10 Monitoring well  
 Was a chemical/bacteriological sample submitted to Department? Yes - No X; If yes, mo/day/yr sample was submitted -  
 Water Well Disinfected? Yes - No X

5 TYPE OF BLANK CASING USED:  
 1 Steel 3 RMP (SR) 5 Wrought iron 8 Concrete tile CASING JOINTS: Glued - Clamped -  
2 PVC 4 ABS 6 Asbestos-Cement 9 Other (specify below) Welded -  
 7 Fiberglass Threaded X  
 Blank casing diameter 2 in. to 4.8 ft. Dia - in. to - ft. Dia - in. to - ft.  
 Casing height above land surface 61 - 0 in., weight SC40 lbs./ft. Wall thickness or gauge No. -  
 TYPE OF SCREEN OR PERFORATION MATERIAL:  
 1 Steel 3 Stainless steel 5 Fiberglass 7 PVC 10 Asbestos-cement  
 2 Brass 4 Galvanized steel 6 Concrete tile 8 RMP (SR) 11 Other (specify) -  
 9 ABS 12 None used (open hole)  
 SCREEN OR PERFORATION OPENINGS ARE:  
 1 Continuous slot 3 Mill slot 5 Gauze wrapped 8 Saw cut 11 None (open hole)  
 2 Louvered shutter 4 Key punched 6 Wire wrapped 9 Drilled holes  
 7 Torch cut 10 Other (specify) -  
 SCREEN-PERFORATED INTERVALS: From 4.8 ft. to 14.8 ft., From - ft. to - ft.  
SAND From 4 ft. to - ft., From - ft. to - ft.  
 GRAVEL PACK INTERVALS: From 3.8 ft. to 15 ft., From - ft. to - ft.  
 From - ft. to - ft., From - ft. to - ft.

6 GROUT MATERIAL: 1 Neat cement 2 Cement grout 3 Bentonite 4 Other -  
 Grout Intervals: From 0 ft. to 1.8 ft., From 3 ft. to 3.8 ft., From - ft. to - ft.  
 What is the nearest source of possible contamination:  
 1 Septic tank 4 Lateral lines 7 Pit privy 10 Livestock pens 14 Abandoned water well  
 2 Sewer lines 5 Cess pool 8 Sewage lagoon 11 Fuel storage TK REMAINS Oil well/Gas well  
 3 Watertight sewer lines 6 Seepage pit 9 Feedyard 12 Fertilizer storage 16 Other (specify below)  
 13 Insecticide storage -  
 Direction from well? How many feet?

FROM	TO	LITHOLOGIC LOG	FROM	TO	PLUGGING INTERVALS
<u>GL-D</u>	<u>1</u>	<u>ASPHALT + CONCRETE</u>			
<u>1</u>	<u>2</u>	<u>SILTY CLAY-GRAY</u>			
<u>2</u>	<u>5</u>	<u>SILTY CLAY BROWN</u>			
<u>5</u>	<u>13</u>	<u>SILT</u>			
<u>13</u>	<u>15</u>	<u>SAND</u>			
<u>TD</u>	<u>15</u>				
<u>FLUSH MOUNT WAIVER</u> <u>07-19-94 - DON TAYLOR</u>					

7 CONTRACTOR'S OR LANDOWNER'S CERTIFICATION: This water well was (1) constructed, (2) reconstructed, or (3) plugged under my jurisdiction and was completed on (mo/day/year) 08-09-94 and this record is true to the best of my knowledge and belief. Kansas  
 Water Well Contractor's License No. 479 This Water Well Record was completed on (mo/day/yr) 09-06-94  
 under the business name of ERRBERTS DRILLING by (signature) Suzanne Elberts