


1 LOCATION OF WATER WELL: Fraction NE 1/4 NE 1/4 SW 1/4 Section Number 17 Township Number T 23 S Range Number R 1E
 County: HARVEY

Distance and direction from nearest town or city street address of well if located within city?
132 W 5TH ST. NEWTON

2 WATER WELL OWNER: CITY OF NEWTON
 RR#, St. Address, Box # ATT. RICHARD OLLER - PO BOX 426 - NEWTON KS. 67114 Board of Agriculture, Division of Water Resources
 City, State, ZIP Code Application Number:

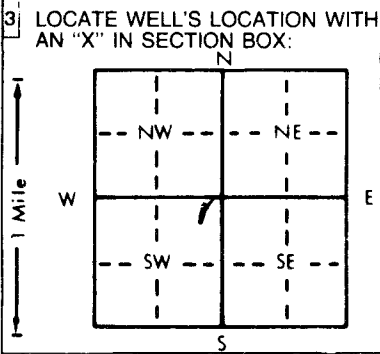

4 DEPTH OF COMPLETED WELL: 15 ft. ELEVATION:
 Depth(s) Groundwater Encountered 1. 8.5 ft. 2. - ft. 3. - ft.
 WELL'S STATIC WATER LEVEL: 9.78 ft. below land surface measured on mo/day/yr 08-16-94
 Pump test data: Well water was - ft. after - hours pumping - gpm
 Est. Yield - gpm: Well water was - ft. after - hours pumping - gpm
 Bore Hole Diameter: 8.625 in. to 15 ft. and - in. to - ft.
 WELL WATER TO BE USED AS:
 5 Public water supply 8 Air conditioning 11 Injection well
 1 Domestic 3 Feedlot 6 Oil field water supply 9 Dewatering 12 Other (Specify below)
 2 Irrigation 4 Industrial 7 Lawn and garden only 10 Monitoring well
 Was a chemical/bacteriological sample submitted to Department? Yes - No X; If yes, mo/day/yr sample was submitted
 Water Well Disinfected? Yes - No X

5 TYPE OF BLANK CASING USED:
 1 Steel 3 RMP (SR) 5 Wrought iron 8 Concrete tile CASING JOINTS: Glued - Clamped -
 2 PVC 4 ABS 6 Asbestos-Cement 9 Other (specify below) Welded -
 7 Fiberglass Threaded X
 Blank casing diameter 2 in. to 5 ft. Dia - in. to - ft. Dia - in. to - ft.
 Casing height above land surface 0 in., weight SCH 40 lbs./ft. Wall thickness or gauge No. -
 TYPE OF SCREEN OR PERFORATION MATERIAL:
 1 Steel 3 Stainless steel 5 Fiberglass 7 PVC 10 Asbestos-cement
 2 Brass 4 Galvanized steel 6 Concrete tile 8 RMP (SR) 11 Other (specify) -
 9 ABS 12 None used (open hole)
 SCREEN OR PERFORATION OPENINGS ARE:
 1 Continuous slot 3 Mill slot 5 Gauzed wrapped 8 Saw cut 11 None (open hole)
 2 Louvered shutter 4 Key punched 6 Wire wrapped 9 Drilled holes
 7 Torch cut 10 Other (specify) -
 SCREEN-PERFORATED INTERVALS: From 5 ft. to 15 ft. From - ft. to - ft. From - ft. to - ft.
 From - ft. to - ft. From - ft. to - ft. From - ft. to - ft.
 SAND GRAVEL PACK INTERVALS: From 4 ft. to 15 ft. From - ft. to - ft. From - ft. to - ft.
 From - ft. to - ft. From - ft. to - ft. From - ft. to - ft.

6 GROUT MATERIAL: 1 Neat cement 2 Cement grout 3 Bentonite 4 Other -
 Grout Intervals: From 0 ft. to 2 ft. From 2 ft. to 4 ft. From - ft. to - ft. From - ft. to - ft.
 What is the nearest source of possible contamination:
 1 Septic tank 4 Lateral lines 7 Pit privy 10 Livestock pens 14 Abandoned water well
 2 Sewer lines 5 Cess pool 8 Sewage lagoon 11 Fuel storage TU REMAID oil well/Gas well
 3 Watertight sewer lines 6 Seepage pit 9 Feedyard 12 Fertilizer storage 16 Other (specify below)
 13 Insecticide storage -

Direction from well? How many feet? -

FROM	TO	LITHOLOGIC LOG	FROM	TO	PLUGGING INTERVALS
<u>GL-D</u>	<u>1</u>	<u>SOIL</u>			
<u>1</u>	<u>5</u>	<u>SILTY CLAY</u>			
<u>5</u>	<u>9</u>	<u>SANDY CLAY</u>			
<u>9</u>	<u>14</u>	<u>SAND WITH SILT</u>			
<u>14</u>	<u>15</u>	<u>SHALE</u>			
<u>TD</u>	<u>15</u>				
		<u>FLUSH MOUNT WATER</u>			
		<u>09-19-94</u>			
		<u>DOU TAYLOR</u>			

7 CONTRACTOR'S OR LANDOWNER'S CERTIFICATION: This water well was (1) constructed, (2) reconstructed, or (3) plugged under my jurisdiction and was completed on (mo/day/year) 08-10-94 and this record is true to the best of my knowledge and belief. Kansas Water Well Contractor's License No. 479 This Water Well Record was completed on (mo/day/yr) 09-06-94 under the business name of EBBERTS DRILLING by (signature) Angus Ebert