


#7

1 LOCATION OF WATER WELL: Fraction SE 1/4 NE 1/4 NW 1/4 Section Number 17 Township Number T 23 S Range Number R 1 E EW
 County: HARVEY

Distance and direction from nearest town or city street address of well if located within city?
825 N MAIN - NEWTON

2 WATER WELL OWNER: CITY OF NEWTON KS
 RR#, St. Address, Box # ATT. RICHARD OLLER RD. BOX 426 - NEWTON KS 67114 Board of Agriculture, Division of Water Resources
 City, State, ZIP Code: NEWTON KS 67114 Application Number:

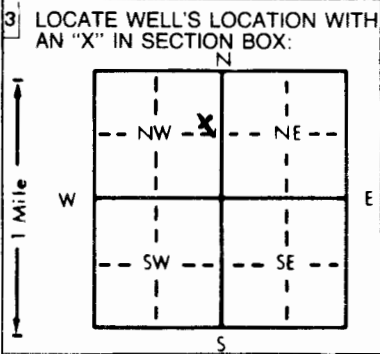

4 DEPTH OF COMPLETED WELL: 15 ft. ELEVATION:
 Depth(s) Groundwater Encountered 1. 8 ft. 2. - ft. 3. - ft.
 WELL'S STATIC WATER LEVEL 9.61 ft. below land surface measured on 08-16-94
 Pump test data: Well water was - ft. after - hours pumping - gpm
 Est. Yield - gpm: Well water was - ft. after - hours pumping - gpm
 Bore Hole Diameter 8.625 in. to 15 ft., and - in. to - ft.
 WELL WATER TO BE USED AS:
 5 Public water supply 8 Air conditioning 11 Injection well
 1 Domestic 3 Feedlot 6 Oil field water supply 9 Dewatering 12 Other (Specify below)
 2 Irrigation 4 Industrial 7 Lawn and garden only 10 Monitoring well
 Was a chemical/bacteriological sample submitted to Department? Yes - No X; If yes, mo/day/yr sample was sub-
 mitted - Water Well Disinfected? Yes - No X

5 TYPE OF BLANK CASING USED:
 1 Steel 3 RMP (SR) 5 Wrought iron 8 Concrete tile CASING JOINTS: Glued - Clamped -
 2 PVC 4 ABS 6 Asbestos-Cement 9 Other (specify below) Welded -
 7 Fiberglass Threaded X
 Blank casing diameter 2 in. to 5 ft., Dia - in. to - ft., Dia - in. to - ft.
 Casing height above land surface 6L-0 in., weight SCH 40 lbs./ft. Wall thickness or gauge No. -
 TYPE OF SCREEN OR PERFORATION MATERIAL:
 1 Steel 3 Stainless steel 5 Fiberglass 7 PVC 10 Asbestos-cement
 2 Brass 4 Galvanized steel 6 Concrete tile 8 RMP (SR) 11 Other (specify) -
 9 ABS 12 None used (open hole)
 SCREEN OR PERFORATION OPENINGS ARE:
 1 Continuous slot 3 Mill slot 5 Gauzed wrapped 8 Saw cut 11 None (open hole)
 2 Louvered shutter 4 Key punched 6 Wire wrapped 9 Drilled holes
 7 Torch cut 10 Other (specify) -
 SCREEN-PERFORATED INTERVALS: From 5 ft. to 15 ft., From - ft. to - ft.
SAND From 4 ft. to 15 ft., From - ft. to - ft.
~~GRAVEL~~ PACK INTERVALS: From - ft. to - ft., From - ft. to - ft.

6 GROUT MATERIAL: 1 Neat cement 2 Cement grout 3 Bentonite 4 Other -
 Grout Intervals: From 6L-0 ft. to 2 ft., From 0-2 ft. to 4 ft., From - ft. to - ft.
 What is the nearest source of possible contamination:
 1 Septic tank 4 Lateral lines 7 Pit privy 10 Livestock pens 14 Abandoned water well
 2 Sewer lines 5 Cess pool 8 Sewage lagoon 11 Fuel storage 15 Oil well/Gas well
 3 Watertight sewer lines 6 Seepage pit 9 Feedyard 12 Fertilizer storage 16 Other (specify below)
 13 Insecticide storage TANKS REMOVED
 Direction from well? - How many feet? CONTAMINATED

FROM	TO	LITHOLOGIC LOG	FROM	TO	PLUGGING INTERVALS
<u>6L-0</u>	<u>2</u>	<u>SOIL</u>			
<u>2</u>	<u>7</u>	<u>SILTY CLAY</u>			
<u>7</u>	<u>15</u>	<u>SHALE</u>			
<u>TD</u>	<u>15</u>				
		<u>FLUSH MOUNT WEAVER</u>			
		<u>DON TAYLOR - 0719-94</u>			

7 CONTRACTOR'S OR LANDOWNER'S CERTIFICATION: This water well was (1) constructed, (2) reconstructed, or (3) plugged under my jurisdiction and was completed on (mo/day/year) 03-02-94 and this record is true to the best of my knowledge and belief. Kansas
 Water Well Contractor's License No. 479 This Water Well Record was completed on (mo/day/yr) 08-18-94
 under the business name of EBBERTS DRILLING by (signature) Stephen Ebberts