


#1

1 LOCATION OF WATER WELL: Fraction BE 1/4 NE 1/4 SW 1/4 Section Number 17 Township Number T 23 S Range Number R 1E EW
 County: HARVEY

Distance and direction from nearest town or city street address of well if located within city?
132 W 5TH ST - NEWTON

2 WATER WELL OWNER: HOLSTINE MOTORS
 RR#, St. Address, Box #: 132 W 5TH ST. NEWTON, KS 67114 Board of Agriculture, Division of Water Resources
 City, State, ZIP Code: Application Number:

3 LOCATE WELL'S LOCATION WITH AN "X" IN SECTION BOX:

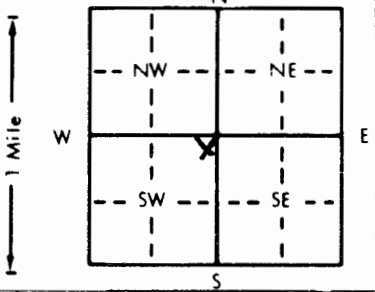

4 DEPTH OF COMPLETED WELL: 17 ft. ELEVATION:

Depth(s) Groundwater Encountered 1. 9.8 ft. 2. - ft. 3. - ft.
 WELL'S STATIC WATER LEVEL 9.96 ft. below land surface measured on mo/day/yr 08-16-94
 Pump test data: Well water was - ft. after - hours pumping - gpm
 Est. Yield - gpm: Well water was - ft. after - hours pumping - gpm
 Bore Hole Diameter 8.625 in. to 17 ft. and - in. to - ft.
 WELL WATER TO BE USED AS:
 5 Public water supply 8 Air conditioning 11 Injection well
 1 Domestic 3 Feedlot 6 Oil field water supply 9 Dewatering 12 Other (Specify below)
 2 Irrigation 4 Industrial 7 Lawn and garden only 10 Monitoring well
 Was a chemical/bacteriological sample submitted to Department? Yes - No X; If yes, mo/day/yr sample was submitted -
 Water Well Disinfected? Yes - No X

5 TYPE OF BLANK CASING USED:
 1 Steel 3 RMP (SR) 5 Wrought iron 8 Concrete tile CASING JOINTS: Glued - Clamped -
2 PVC 4 ABS 6 Asbestos-Cement 9 Other (specify below) Welded -
 7 Fiberglass Threaded X

Blank casing diameter 2 in. to 6.6 ft. Dia - in. to - ft. Dia - in. to - ft.
 Casing height above land surface 6.6 in. weight SC# 40 lbs./ft. Wall thickness or gauge No. -

TYPE OF SCREEN OR PERFORATION MATERIAL:
 1 Steel 3 Stainless steel 5 Fiberglass 8 RMP (SR) 11 Other (specify) -
 2 Brass 4 Galvanized steel 6 Concrete tile 9 ABS 12 None used (open hole)

SCREEN OR PERFORATION OPENINGS ARE:
 1 Continuous slot 3 Mill slot 5 Gauzed wrapped 8 Saw cut 11 None (open hole)
 2 Louvered shutter 4 Key punched 6 Wire wrapped 9 Drilled holes
 7 Torch cut 10 Other (specify) -

SCREEN-PERFORATED INTERVALS: From 6.6 ft. to 16.6 ft. From - ft. to - ft.
 From - ft. to - ft. From - ft. to - ft.
SAND
 GRAVEL PACK INTERVALS: From 5.6 ft. to 17 ft. From - ft. to - ft.
 From - ft. to - ft. From - ft. to - ft.

6 GROUT MATERIAL: 1 Neat cement 2 Cement grout 3 Bentonite 4 Other -
 Grout Intervals: From 0 ft. to 3.6 ft. From 3.6 ft. to 5.6 ft. From - ft. to - ft.

What is the nearest source of possible contamination:
 1 Septic tank 4 Lateral lines 7 Pit privy 10 Livestock pens 14 Abandoned water well
 2 Sewer lines 5 Cess pool 8 Sewage lagoon 11 Fuel storage REMOVED 15 Oil well/Gas well
 3 Watertight sewer lines 6 Seepage pit 9 Feedyard 12 Fertilizer storage 16 Other (specify below)
 13 Insecticide storage

Direction from well? - How many feet? -

FROM	TO	LITHOLOGIC LOG	FROM	TO	PLUGGING INTERVALS
<u>0L-D</u>	<u>2</u>	<u>ASPHALT + FILL SAND</u>			
<u>2</u>	<u>5</u>	<u>SILTY CLAY</u>			
<u>5</u>	<u>10</u>	<u>SANDY CLAY</u>			
<u>10</u>	<u>15</u>	<u>SILT</u>			
<u>15</u>	<u>17</u>	<u>SHALE</u>			
<u>TD</u>	<u>17</u>				
<u>FLUSH MOUNT WAIVER</u> <u>07-19-94</u> <u>DW TAYLOR</u>					

7 CONTRACTOR'S OR LANDOWNER'S CERTIFICATION: This water well was (1) constructed, (2) reconstructed, or (3) plugged under my jurisdiction and was completed on (mo/day/year) 08-08-94 and this record is true to the best of my knowledge and belief. Kansas
 Water Well Contractor's License No. H79 This Water Well Record was completed on (mo/day/yr) 09-06-94
 under the business name of EBBETTS DRILLING by (signature) [Signature]