

CORRECTION(S) TO WATER WELL RECORD (WWC-5)
(to rectify lacking or incorrect information)

County: Harvey

Location listed as:

Section-Township-Range: 24-235-1E

Fraction ($\frac{1}{4}$ $\frac{1}{4}$ $\frac{1}{4}$): NW NW NW

Location changed to:

18-235-1E

SW SW SW

Other changes: Initial statements: _____

Changed to: _____

Comments: _____

verification method: Well address, area map on internet, proximity of other monitoring wells at same address by same owner, and Newton 1:24,000 topo. map. initials: DRL date: 4/11/2005

submitted by: Kansas Geological Survey, Data Resources Library, 1930 Constant Ave., Lawrence, KS 66047-3726


to: Kansas Dept of Health & Environment, Bureau of Water, 1000 SW Jackson, Suite 420, Topeka, KS 66612-1367.

MW-6 2111059

1 LOCATION OF WATER WELL:	Fraction	Section Number	Township Number	Range Number
County: <u>Harvey</u>	<u>NW 1/4 NW 1/4 NW 1/4</u>	<u>24</u>	<u>T 23 S</u>	<u>R 1 E/W</u>

Distance and direction from nearest town or city street address of well if located within city?
100 N. Meridian, Newton

2 WATER WELL OWNER: Gary Davidson
 RR#, St. Address, Box #: #6 Cedar Drive
 City, State, ZIP Code: Halstead, KS 67056
 Board of Agriculture, Division of Water Resources
 Application Number:

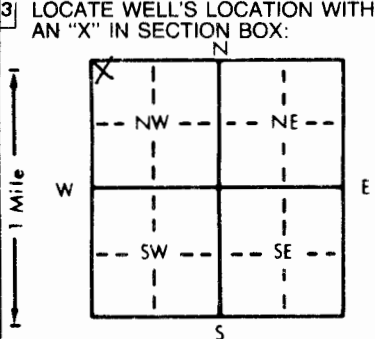

4 DEPTH OF COMPLETED WELL: 21 ft. ELEVATION: 17.5 ft.
 Depth(s) Groundwater Encountered: 14.67 ft. 2. 17.5 ft. 3. 6-7-94 ft.
 WELL'S STATIC WATER LEVEL: 14.67 ft. below land surface measured on mo/day/yr 6-7-94
 Pump test data: Well water was _____ ft. after _____ hours pumping _____ gpm
 Est. Yield _____ gpm: Well water was _____ ft. after _____ hours pumping _____ gpm
 Bore Hole Diameter: 8 in. to _____ ft., and _____ in. to _____ ft.
 WELL WATER TO BE USED AS:
 1 Domestic 3 Feedlot 6 Oil field water supply 9 Dewatering 12 Other (Specify below)
 2 Irrigation 4 Industrial 7 Lawn and garden only 10 Monitoring well
 Was a chemical/bacteriological sample submitted to Department? Yes _____ No Y; If yes, mo/day/yr sample was sub-
 mitted _____ Water Well Disinfected? Yes _____ No X

5 TYPE OF BLANK CASING USED:
 1 Steel 3 RMP (SR) 5 Wrought iron 8 Concrete tile CASING JOINTS: Glued _____ Clamped _____
2 PVC 4 ABS 7 Fiberglass _____ Welded _____
Threaded Flush
 Blank casing diameter _____ in. to _____ ft., Dia. _____ in. to _____ ft., Dia. _____ in. to _____ ft.
 Casing height above land surface: Flush in., weight 7.03 lbs./ft. Wall thickness or gauge No. 1.54
 TYPE OF SCREEN OR PERFORATION MATERIAL:
 1 Steel 3 Stainless steel 5 Fiberglass 8 RMP (SR) 10 Asbestos-cement
 2 Brass 4 Galvanized steel 6 Concrete tile 9 ABS 12 None used (open hole)
 SCREEN OR PERFORATION OPENINGS ARE:
 1 Continuous slot 3 Mill slot 5 Gauzed wrapped 8 Saw cut 11 None (open hole)
 2 Louvered shutter 4 Key punched 6 Wire wrapped 9 Drilled holes
 7 Torch cut 10 Other (specify) _____
 SCREEN-PERFORATED INTERVALS: From 11 ft. to 21 ft., From _____ ft. to _____ ft.
 From _____ ft. to _____ ft., From _____ ft. to _____ ft.
 GRAVEL PACK INTERVALS: From 9 ft. to 21 ft., From _____ ft. to _____ ft.
 From _____ ft. to _____ ft., From _____ ft. to _____ ft.

6 GROUT MATERIAL: 1 Neat cement 2 Cement grout 3 Bentonite 4 Other _____
 Grout Intervals: From 2 ft. to 9 ft., From _____ ft. to _____ ft., From _____ ft. to _____ ft.
 What is the nearest source of possible contamination:
 1 Septic tank 4 Lateral lines 7 Pit privy 11 Fuel storage 14 Abandoned water well
 2 Sewer lines 5 Cess pool 8 Sewage lagoon 12 Fertilizer storage 15 Oil well/Gas well
 3 Watertight sewer lines 6 Seepage pit 9 Feedyard 13 Insecticide storage 16 Other (specify below) _____

Direction from well? NE How many feet? 250

FROM	TO	LITHOLOGIC LOG	FROM	TO	PLUGGING INTERVALS
0.0	2.0	clay very silty			
2.0	7.0	clay very silty, slightly sandy			
7.0	16.0	clay very silty and sandy			
16.0	21.0	clay silty, slightly sandy			

Allison Irwin contacted Don Taylor on 4-27-94 about forms being turned in late.

7 CONTRACTOR'S OR LANDOWNER'S CERTIFICATION: This water well was (1) constructed (2) reconstructed, or (3) plugged under my jurisdiction and was completed on (mo/day/year) 4-25-94 and this record is true to the best of my knowledge and belief. Kansas Water Well Contractor's License No. 531 This Water Well Record was completed on (mo/day/yr) 8-9-94 under the business name of GSI by (signature) Allison Irwin