


MW-12 2111059

1) LOCATION OF WATER WELL: Fraction SW 1/4 SW 1/4 SW 1/4 Section Number 18 Township Number T 23 S Range Number R 1 EW

Distance and direction from nearest town or city street address of well if located within city? 100 N. Meridian, Newton

2) WATER WELL OWNER: Gary Davidson RR#, St. Address, Box #: #6 Cedar Drive City, State, ZIP Code: Halstead, KS 67056 Board of Agriculture, Division of Water Resources Application Number:

3) LOCATE WELL'S LOCATION WITH AN "X" IN SECTION BOX:

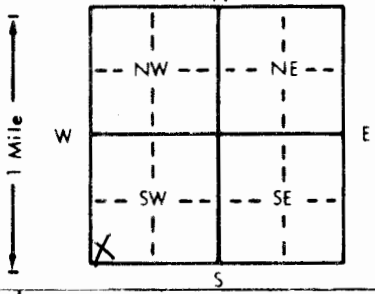

4) DEPTH OF COMPLETED WELL: 21 ft. ELEVATION: Depth(s) Groundwater Encountered: 17.5 ft. 2. WELL'S STATIC WATER LEVEL: 15.11 ft. below land surface measured on mo/day/yr 6-7-94 Pump test data: Well water was ... ft. after ... hours pumping ... gpm Est. Yield ... gpm: Well water was ... ft. after ... hours pumping ... gpm Bore Hole Diameter: 8 in. to ... ft., and ... in. to ... ft. WELL WATER TO BE USED AS: 5 Public water supply 8 Air conditioning 11 Injection well 1 Domestic 3 Feedlot 6 Oil field water supply 9 Dewatering 12 Other (Specify below) 2 Irrigation 4 Industrial 7 Lawn and garden only 10 Monitoring well Was a chemical/bacteriological sample submitted to Department? Yes ... No X; If yes, mo/day/yr sample was submitted Water Well Disinfected? Yes No X

5) TYPE OF BLANK CASING USED: 1 Steel 3 RMP (SR) 6 Asbestos-Cement 9 Other (specify below) 2 PVC 4 ABS 7 Fiberglass CASING JOINTS: Glued Clamped Welded Threaded Flush Blank casing diameter ... in. to ... ft., Dia ... in. to ... ft., Dia ... in. to ... ft. Casing height above land surface: Flush in, weight: 70.3 lbs./ft. Wall thickness or gauge No.: 154

TYPE OF SCREEN OR PERFORATION MATERIAL: 1 Steel 3 Stainless steel 5 Fiberglass 8 RMP (SR) 10 Asbestos-cement 2 Brass 4 Galvanized steel 6 Concrete tile 9 ABS 11 Other (specify) 12 None used (open hole)

SCREEN OR PERFORATION OPENINGS ARE: 1 Continuous slot 3 Mill slot 6 Wire wrapped 9 Drilled holes 2 Louvered shutter 4 Key punched 7 Torch cut 10 Other (specify) 8 Saw cut 11 None (open hole)

SCREEN-PERFORATED INTERVALS: From 11 ft. to 21 ft., From ... ft. to ... ft. GRAVEL PACK INTERVALS: From 9 ft. to 21 ft., From ... ft. to ... ft.

6) GROUT MATERIAL: 1 Neat cement 2 Cement grout 3 Bentonite 4 Other Grout Intervals: From 2 ft. to 9 ft., From ... ft. to ... ft.

What is the nearest source of possible contamination: 1 Septic tank 4 Lateral lines 7 Pit privy 10 Livestock pens 14 Abandoned water well 2 Sewer lines 5 Cess pool 8 Sewage lagoon 11 Fuel storage 15 Oil well/Gas well 3 Watertight sewer lines 6 Seepage pit 9 Feedyard 12 Fertilizer storage 16 Other (specify below) 13 Insecticide storage

Direction from well? SW How many feet? ~18

Table with columns: FROM, TO, LITHOLOGIC LOG, FROM, TO, PLUGGING INTERVALS. Row 1: 0.0, 14.0, clay very silty slightly sandy. Row 2: 14.0, 21.0, silt, clayey.

Allison Irwin contacted Don Taylor on 4-27-94 about forms being turned in late.

7) CONTRACTOR'S OR LANDOWNER'S CERTIFICATION: This water well was (1) constructed (2) reconstructed, or (3) plugged under my jurisdiction and was completed on (mo/day/year) 4-25-94 and this record is true to the best of my knowledge, and belief. Kansas Water Well Contractor's License No. 531 This Water Well Record was completed on (mo/day/yr) 8-9-94 under the business name of GSI by (signature) Allison Irwin