


1 LOCATION OF WATER WELL: Fraction Ne 1/4 Sec 1/4 SW 1/4 Section Number 2 Township Number T 23 S Range Number R 1 E/W
 County: Harvey
 Distance and direction from nearest town or city street address of well if located within city?
329 Campers Ct.

2 WATER WELL OWNER: Harold Boschmann
 RR#, St. Address, Box #: 329 Campers Ct.
 City, State, ZIP Code: Newton, KS, 67117
 Board of Agriculture, Division of Water Resources
 Application Number:

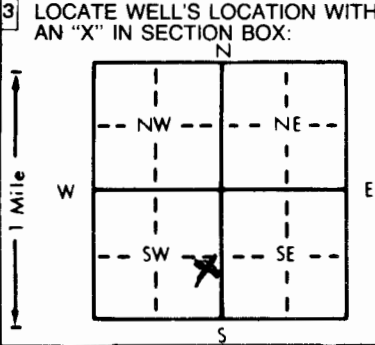

4 DEPTH OF COMPLETED WELL: 94 ft. ELEVATION:
 Depth(s) Groundwater Encountered 15-22 ft. 2. 22 ft. 3. 22 ft.
 WELL'S STATIC WATER LEVEL: 15 ft. below land surface measured on mo/day/yr
 Pump test data: Well water was 15-20 gpm. Well water was 9 ft. after 7 1/2 hours pumping 94 gpm
 Est. Yield 15-20 gpm. Well water was 9 ft. after 7 1/2 hours pumping 94 gpm
 Bore Hole Diameter: 9 in. to 35 ft., and 7 1/2 in. to 94 ft.
 WELL WATER TO BE USED AS:
 1 Domestic 3 Feedlot 6 Oil field water supply 9 Dewatering 12 Other (Specify below)
 2 Irrigation 4 Industrial 7 Lawn and garden only 10 Monitoring well
 Was a chemical/bacteriological sample submitted to Department? Yes No X; If yes, mo/day/yr sample was submitted
 Water Well Disinfected? Yes X No

5 TYPE OF BLANK CASING USED:
 1 Steel 3 RMP (SR) 5 Wrought iron 8 Concrete tile CASING JOINTS: Glued X Clamped
 2 PVC 4 ABS 6 Asbestos-Cement 9 Other (specify below) Welded
 7 Fiberglass Threaded
 Blank casing diameter 5 in. to 22 ft. Dia. 5 in. to 20 ft. Dia. in. to 20 ft.
 Casing height above land surface 12 in., weight 5 DR 26 lbs./ft. Wall thickness or gauge No. 214
 TYPE OF SCREEN OR PERFORATION MATERIAL:
 1 Steel 3 Stainless steel 5 Fiberglass 7 PVC 10 Asbestos-cement
 2 Brass 4 Galvanized steel 6 Concrete tile 8 RMP (SR) 11 Other (specify)
 9 ABS 12 None used (open hole)
 SCREEN OR PERFORATION OPENINGS ARE:
 1 Continuous slot 3 Mill slot 5 Gauzed wrapped 8 Saw cut 11 None (open hole)
 2 Louvered shutter 4 Key punched 6 Wire wrapped 9 Drilled holes
 7 Torch cut 10 Other (specify)

6 GROUT MATERIAL: 1 Neat cement 2 Cement grout 3 Bentonite 4 Other
 What is the nearest source of possible contamination:
 1 Septic tank 4 Lateral lines 7 Pit privy 10 Livestock pens 14 Abandoned water well
 2 Sewer lines 5 Cess pool 8 Sewage lagoon 11 Fuel storage 15 Oil well/Gas well
 3 Watertight sewer lines 6 Seepage pit 9 Feedyard 12 Fertilizer storage 16 Other (specify below)
 13 Insecticide storage
 Direction from well? W How many feet? 30

FROM	TO	LITHOLOGIC LOG	FROM	TO	PLUGGING INTERVALS
0	18	Clay			
18	28	Sand			
28	61	Shale			
61	63	Broken Shale			
63	28	Shale			
28	29	Loose Shale			
29	94	Shale			

7 CONTRACTOR'S OR LANDOWNER'S CERTIFICATION: This water well was (1) constructed, (2) reconstructed, or (3) plugged under my jurisdiction and was completed on (mo/day/year) 8-25-94 and this record is true to the best of my knowledge and belief. Kansas Water Well Contractor's License No. 180 This Water Well Record was completed on (mo/day/yr) 9-1-94 under the business name of Bachhus Drilling by (signature) Paul H. Bachhus