


1 LOCATION OF WATER WELL: Fraction NE 1/4 NE 1/4 NE 1/4 Section Number 21 Township Number T 23 S Range Number R 1 EW  
 County: Harvey 090

Distance and direction from nearest town or city street address of well if located within city?

1609 E. 1st, Newton, KS

2 WATER WELL OWNER: Charles Hill  
 RR#, St. Address, Box #: 409 Sherman  
 City, State, ZIP Code: Newton, KS 67114  
 Board of Agriculture, Division of Water Resources  
 Application Number:

3 LOCATE WELL'S LOCATION WITH AN "X" IN SECTION BOX:

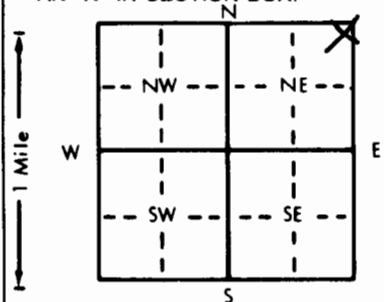

4 DEPTH OF COMPLETED WELL: 15 ft. ELEVATION:

Depth(s) Groundwater Encountered 1 ft. 10 ft. 2. ft. 3. ft.

WELL'S STATIC WATER LEVEL 9.75 ft. below land surface measured on mo/day/yr 1-26-95

Pump test data: Well water was N/A ft. after hours pumping gpm

Est. Yield N/A gpm; Well water was N/A ft. after hours pumping gpm

Bore Hole Diameter 8 in. to 15 ft., and in. to ft.

WELL WATER TO BE USED AS: 5 Public water supply 8 Air conditioning 11 Injection well

1 Domestic 3 Feedlot 6 Oil field water supply 9 Dewatering 12 Other (Specify below)

2 Irrigation 4 Industrial 7 Lawn and garden only 10 Monitoring Well MW-4

Was a chemical/bacteriological sample submitted to Department? Yes No X; If yes, mo/day/yr sample was submitted

Water Well Disinfected? Yes No

5 TYPE OF BLANK CASING USED: 5 Wrought iron 8 Concrete tile CASING JOINTS: Glued Clamped

1 Steel 3 RMP (SR) 6 Asbestos-Cement 9 Other (specify below) Welded

2 PVC 4 ABS 7 Fiberglass Threaded X

Blank casing diameter 2 in. to 5 ft., Dia. in. to ft., Dia. in. to ft.

Casing height above land surface 0 in., weight lbs./ft. Wall thickness or gauge No. 40

TYPE OF SCREEN OR PERFORATION MATERIAL: 7 PVC 10 Asbestos-cement

1 Steel 3 Stainless steel 5 Fiberglass 8 RMP (SR) 11 Other (specify)

2 Brass 4 Galvanized steel 6 Concrete tile 9 ABS 12 None used (open hole)

SCREEN OR PERFORATION OPENINGS ARE: 5 Gauzed wrapped 8 Saw cut 11 None (open hole)

1 Continuous slot 3 Mill slot 6 Wire wrapped 9 Drilled holes

2 Louvered shutter 4 Key punched 7 Torch cut 10 Other (specify)

SCREEN-PERFORATED INTERVALS: From 5 ft. to 15 ft., From ft. to ft.

From ft. to ft., From ft. to ft.

GRAVEL PACK INTERVALS: From 3 ft. to 15 ft., From ft. to ft.

From ft. to ft., From ft. to ft.

6 GROUT MATERIAL: 1 Neat cement 2 Cement grout 3 Bentonite 4 Other

Grout Intervals: From 0 ft. to 0.5 ft., From 0.5 ft. to 3 ft., From ft. to ft.

What is the nearest source of possible contamination: 10 Livestock pens 14 Abandoned water well

1 Septic tank 4 Lateral lines 7 Pit privy 11 Fuel storage 15 Oil well/Gas well

2 Sewer lines 5 Cess pool 8 Sewage lagoon 12 Fertilizer storage 16 Other (specify below)

3 Watertight sewer lines 6 Seepage pit 9 Feedyard 13 Insecticide storage

Direction from well? S How many feet? 40

FROM TO LITHOLOGIC LOG FROM TO PLUGGING INTERVALS

0 1 Asphalt + gravel base

1 5.5 Brown/black Silty Clay

5.5 7 Tan sand

7 14.5 Gray clay w/ sand

14.5 15 Shale

7 CONTRACTOR'S OR LANDOWNER'S CERTIFICATION: This water well was (1) constructed, (2) reconstructed, or (3) plugged under my jurisdiction and was completed on (mo/day/year) 1-24-95 and this record is true to the best of my knowledge and belief. Kansas

Water Well Contractor's License No. 571 This Water Well Record was completed on (mo/day/yr) 3-2-95

under the business name of BDAT Environmental, Inc by (signature) By Elling