


MW-4 2211089

WATER WELL RECORD Form WWC-5 KSA 82a-1212

1 LOCATION OF WATER WELL: County: Harvey Fraction: S 1/2 NE 1/4 SE 1/4 Section Number: 6 Township Number: T 23 S Range Number: R 1 EW

Distance and direction from nearest town or city street address of well if located within city? 2800 N Old Hwy 81

2 WATER WELL OWNER: RR#, St. Address, Box #: Prestressed concrete PO Box 311 City, State, ZIP Code: Newton KS 67114 Board of Agriculture, Division of Water Resources Application Number:

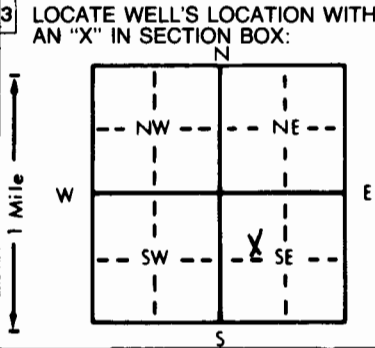

3 LOCATE WELL'S LOCATION WITH AN 'X' IN SECTION BOX: 4 DEPTH OF COMPLETED WELL: 17.5 ft. ELEVATION: Depth(s) Groundwater Encountered: 1. 14 ft. 2. ft. 3. ft. WELL'S STATIC WATER LEVEL: 11.44 ft. below land surface measured on mo/day/yr: 3/6/95

5 TYPE OF BLANK CASING USED: 1 Steel, 2 PVC, 3 RMP (SR), 4 ABS, 5 Wrought iron, 6 Asbestos-Cement, 7 Fiberglass, 8 Concrete tile, 9 Other (specify below), 10 Asbestos-cement, 11 Other (specify), 12 None used (open hole). CASING JOINTS: Glued, Clamped, Welded, Threaded, Flush. Blank casing diameter: 2 in. Dia. Casing height above land surface: Flush in. weight: 703 lbs./ft. Wall thickness or gauge No.: 154. TYPE OF SCREEN OR PERFORATION MATERIAL: 1 Steel, 2 Brass, 3 Stainless steel, 4 Galvanized steel, 5 Fiberglass, 6 Concrete tile, 7 Torch cut, 8 RMP (SR), 9 ABS, 10 Asbestos-cement, 11 Other (specify), 12 None used (open hole). SCREEN OR PERFORATION OPENINGS ARE: 1 Continuous slot, 2 Louvered shutter, 3 Mill slot, 4 Key punched, 5 Gauzed wrapped, 6 Wire wrapped, 7 Torch cut, 8 Saw cut, 9 Drilled holes, 10 Other (specify), 11 None (open hole). SCREEN-PERFORATED INTERVALS: From 7.5 ft. to 17.5 ft. GRAVEL PACK INTERVALS: From 5.5 ft. to 17.5 ft.

6 GROUT MATERIAL: 1 Neat cement, 2 Cement grout, 3 Bentonite, 4 Other. Grout Intervals: From 5.5 ft. to 2.0 ft. What is the nearest source of possible contamination: 1 Septic tank, 2 Sewer lines, 3 Watertight sewer lines, 4 Lateral lines, 5 Cess pool, 6 Seepage pit, 7 Pit privy, 8 Sewage lagoon, 9 Feedyard, 10 Livestock pens, 11 Fuel storage, 12 Fertilizer storage, 13 Insecticide storage, 14 Abandoned water well, 15 Oil well/Gas well, 16 Other (specify below). Direction from well? NW How many feet? 130

Table with columns: FROM, TO, LITHOLOGIC LOG, FROM, TO, PLUGGING INTERVALS. Row 1: 0.0 to 0.5 Concrete. Row 2: 0.5 to 17.5 Silty Clay.

7 CONTRACTOR'S OR LANDOWNER'S CERTIFICATION: This water well was (1) constructed, (2) reconstructed, or (3) plugged under my jurisdiction and was completed on (mo/day/year) 4/13/95 and this record is true to the best of my knowledge and belief. Kansas Water Well Contractor's License No. 531 This Water Well Record was completed on (mo/day/yr) 4/13/95 under the business name of GSI by (signature) Allison J. [unclear]