


1 LOCATION OF WATER WELL: Fraction SE 1/4 SE 1/4 NE 1/4 SE 1/4 Section Number 34 Township Number T 23 S Range Number 15  E  W

Street/Rural Address of Well Location; if unknown, distance & direction from nearest town or intersection: If at owner's address, check here  1926 75 HWY Yates Center, KS 66783

Global Positioning Systems (GPS) information: Latitude: 37.99959 (in decimal degrees) Longitude: -95.73948 (in decimal degrees) Elevation: \_\_\_\_\_ Horizontal Datum:  WGS84,  NAD83,  NAD27 Collection Method: \_\_\_\_\_

2 WATER WELL OWNER: Mark Cross RR#, St. Address, Box #: PO Box 166 City, State ZIP Code: Francis Creek, WI 54214

GPS unit (Make/Model: \_\_\_\_\_)  Digital Map/Photo,  Topographic Map,  Land Survey Est. Accuracy:  < 3 m,  3-5 m,  5-15 m,  > 15 m

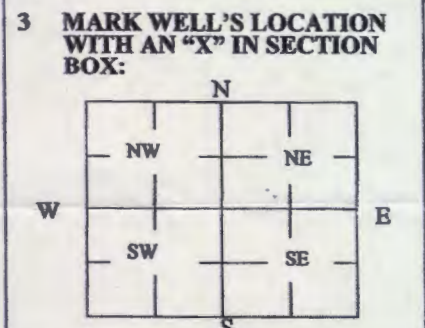

4 DEPTH OF WELL 15 ft. 13ft BDA  
 WELL'S STATIC WATER LEVEL < 5ft. ft  
 WELL WAS USED AS:  
 Domestic  Public Water Supply  Dewatering  
 Irrigation  Oil Field Water Supply  Monitoring  
 Feedlot  Domestic (Lawn & Garden)  Injection Well  
 Industrial  Air Conditioning  Other \_\_\_\_\_  
 Was a chemical/bacteriological sample submitted to Department? Yes  No

5 TYPE OF BLANK CASING USED: No casing was present. Well was an open well when found.  
 Steel  RMP (SR)  Wrought  Fiberglass  Other (Specify below)  
 PVC  ABS  Asbestos-Cement  Concrete Tile Hand dug (Rock)  
 Blank casing diameter 4 1/2 in. Was casing pulled? Yes  No  If yes, how much 5 ft. of rock casing  
 Casing height above or below land surface 60 in.

6 GROUT PLUG MATERIAL:  Neat cement  Cement grout  Bentonite  Other \_\_\_\_\_  
 Grout Plug Intervals: From 6'2" ft. to 4'8" ft., From \_\_\_\_\_ ft. to \_\_\_\_\_ ft., From \_\_\_\_\_ ft. to \_\_\_\_\_ ft.

What is the nearest source of possible contamination:  
 Septic tank  Seepage pit  Fuel storage  Other (specify below)  
 Sewer lines  Pit privy  Fertilizer storage  
 Watertight sewer lines  Sewage lagoon  Insecticide storage  
 Lateral lines  Feedyard  Abandoned water well Direction from well? \_\_\_\_\_  
 Cess pool  Livestock pens  Oil well/Gas well How many feet? \_\_\_\_\_

FROM	TO	PLUGGING MATERIALS	FROM	TO	PLUGGING MATERIALS
		3 gallons of Bleach			
15	10	Well Wall material			
10'	6'2"	1" clean Rock			
6'2	4'8"	Bentonite			
4'8	2'	Clay			
2'	0	Top Soil			

7 CONTRACTOR'S OR LANDOWNER'S CERTIFICATION: This water well was plugged under my jurisdiction and was completed on (mo/day/year) 05/31/2022 and this record is true to the best of my knowledge and belief. Kansas Water Well Contractor's License No. \_\_\_\_\_ This Water Well Record was completed on (mo/day/year) 08/25/2022 under the business name of Landowner by (signature) [Signature]

Send one white copy to Kansas Department of Health & Environment, Geology Section, 1000 SW Jackson Street, Ste. 420, Topeka, KS 66612-1367. Send one copy to WATER WELL OWNER and retain one for your records. Visit us at <http://www.kdheks.gov/waterwell/index.html> Telephone 785-296-5524.