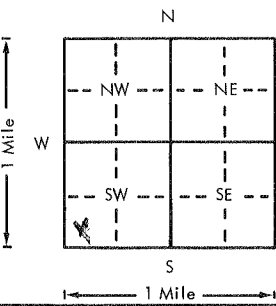
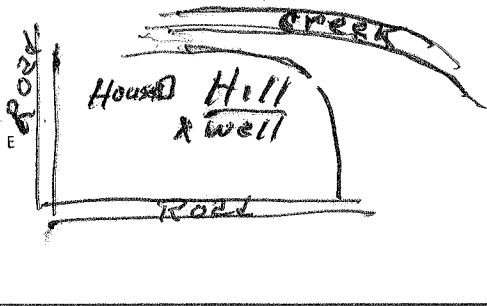


USE TYPEWRITER OR BALL POINT PEN-PRESS FIRMLY, PRINT CLEARLY.

WATER WELL RECORD
KSA 82a-1201-1215

Kansas Department of Health and Environment-Division of Environment
(Water well Contractors)
Topeka, Kansas 66620

| | | | | | | | |
|---|--|--|--|--|---|-------------------------------|--|
| 1. Location of well: | | County Allen | Fraction SW 1/4 SW 1/4 SW 1/4 | Section number 26 | Township number T 23 | Range number S R 19 | <input checked="" type="checkbox"/> EW |
| 2. Distance and direction from nearest town or city: 5 N. Lattarpe - 1 mile west - 1 mi N | | | 3. Owner of well: Buy Garrison | | | | |
| Street address of well location if in city: | | | R.R. or street: RR | | | | |
| | | | City, state, zip code: Lattarpe, Kansas 66751 | | | | |
| 4. Locate with "X" in section below: | | Sketch map: | | | 6. Bore hole dia. 8 3/4 in. Completion date 7/10/18 | | |
|  | |  | | | Well depth 137 ft. | | |
| | | | | | 7. <input checked="" type="checkbox"/> Cable tool <input type="checkbox"/> Rotary <input type="checkbox"/> Driven <input type="checkbox"/> Dug <input type="checkbox"/> Hollow rod <input type="checkbox"/> Jetted <input type="checkbox"/> Bored <input type="checkbox"/> Reverse rotary | | |
| | | | | | 8. Use: <input checked="" type="checkbox"/> Domestic <input type="checkbox"/> Public supply <input type="checkbox"/> Industry <input type="checkbox"/> Irrigation <input type="checkbox"/> Air conditioning <input type="checkbox"/> Stock <input type="checkbox"/> Lawn <input type="checkbox"/> Oil field water <input type="checkbox"/> Other | | |
| | | | | | 9. Casing: Material cast iron Height: Above or below Threaded <input type="checkbox"/> Welded <input type="checkbox"/> Surface 34 in. RMP <input type="checkbox"/> PVC <input checked="" type="checkbox"/> Weight <input type="checkbox"/> lbs./ft. Dia. 5 in. to 37 ft. depth Wall Thickness: inches or Dia. <input type="checkbox"/> in. to <input type="checkbox"/> ft. depth Gage No. 255 | | |
| 5. Type and color of material | | From | To | 10. Screen: Manufacturer's name Jet Stream | | | |
| | | | | Type mw Dia. 5" | | | |
| | | | | Slot/gauze .030 Length 100' | | | |
| | | | | Set between 37 ft. and 137 ft. ft. and <input type="checkbox"/> ft. | | | |
| | | | | Gravel pack? <input checked="" type="checkbox"/> Size range of material 3/4" | | | |
| | | | | 11. Static water level: <input type="checkbox"/> mo./day/yr. 43 ft. below land surface Date 7/10/18 | | | |
| | | | | 12. Pumping level below land surfaces: <input type="checkbox"/> ft. after <input type="checkbox"/> hrs. pumping <input type="checkbox"/> g.p.m. <input type="checkbox"/> ft. after NO TEST hrs. pumping <input type="checkbox"/> g.p.m. Estimated maximum yield <input type="checkbox"/> g.p.m. | | | |
| | | | | 13. Water sample submitted: <input type="checkbox"/> mo./day/yr. <input type="checkbox"/> Yes <input checked="" type="checkbox"/> No Date <input type="checkbox"/> | | | |
| | | | | 14. Well head completion: None <input type="checkbox"/> Pitless adapter 34" inches above grade | | | |
| | | | | 15. Well grouted? <input checked="" type="checkbox"/> With: <input checked="" type="checkbox"/> Neat cement <input type="checkbox"/> Bentonite <input type="checkbox"/> Concrete Depth: From 0 ft. to 10 ft. | | | |
| | | | | 16. Nearest source of possible contamination: ft. 100 Direction N Type Septic Well disinfected upon completion? <input checked="" type="checkbox"/> Yes <input type="checkbox"/> No | | | |
| | | | | 17. Pump: <input checked="" type="checkbox"/> Not installed Manufacturer's name <input type="checkbox"/> Model number <input type="checkbox"/> HP <input type="checkbox"/> Volts <input type="checkbox"/> Length of drop pipe <input type="checkbox"/> ft. capacity <input type="checkbox"/> g.p.m. Type: <input type="checkbox"/> Submersible <input type="checkbox"/> Turbine <input type="checkbox"/> Jet <input type="checkbox"/> Reciprocating <input type="checkbox"/> Centrifugal <input type="checkbox"/> Other | | | |
| | | (Use a second sheet if needed) | | | | | |
| 18. Elevation: | | 19. Remarks: | | | | | |
| Topography: <input checked="" type="checkbox"/> Hill <input type="checkbox"/> Slope <input type="checkbox"/> Upland <input type="checkbox"/> Valley | | 20. Water well contractor's certification: This well was drilled under my jurisdiction and this report is true to the best of my knowledge and belief. Eureka Well Service 296 Business name License No. Address 225 S Walnut Eureka, Kans Signed Travis Applek Date 7/13/18 Authorized representative | | | | | |

23 19 26 5 W 5 W 5 W 1/4 1/4 1/4