


MW-3

WATER WELL PLUGGING RECORD Form WWC-5P KSA 82a-1212 ID NO. []

1 LOCATION OF WATER WELL: Fraction 1/4 NE 1/4 SW 1/4 SW 1/4 Section Number 6 Township Number T 23 S Range Number 19 [] E [] W

Street/Rural Address of Well Location; if unknown, distance & direction from nearest town or intersection: If at owner's address, check here [] 402 Cherry St.; Colony, KS Global Positioning Systems (GPS) information: Latitude: 38.07008 (in decimal degrees) Longitude: 95.3720 (in decimal degrees) Elevation: Datum: [X] WGS84, [] NAD83, [] NAD27 Collection Method: [X] GPS unit (Make/Model: garmin etrek 10) [] Digital Map/Photo, [] Topographic Map, [] Land Survey Est. Accuracy: [] < 3 m, [X] 3-5 m, [] 5-15 m, [] > 15 m

2 WATER WELL OWNER: Phillips 66 RR#, St. Address, Box #: 15604-02 Phillips Bldg. City, State ZIP Code: Bartlesville, OK 74003

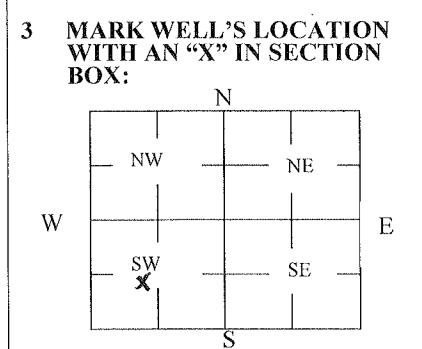

4 DEPTH OF WELL 20 ft. WELL'S STATIC WATER LEVEL _____ ft. WELL WAS USED AS: [] Domestic [] Irrigation [] Feedlot [] Industrial [] Public Water Supply [] Oil Field Water Supply [] Domestic (Lawn & Garden) [] Air Conditioning [] Dewatering [X] Monitoring [] Injection Well [] Other _____ Was a chemical/bacteriological sample submitted to Department? Yes [] No [X]

5 TYPE OF BLANK CASING USED: [] Steel [X] PVC [] RMP (SR) [] ABS [] Wrought Asbestos-Cement [] Fiberglass [] Concrete Tile [] Other (Specify below) _____ Blank casing diameter 2 in. Was casing pulled? Yes [X] No [] If yes, how much all Casing height above or below land surface -6 in.

6 GROUT PLUG MATERIAL: [] Neat cement [] Cement grout [X] Bentonite [] Other _____ Grout Plug Intervals: From 3 ft. to 20 ft., From _____ ft. to _____ ft., From _____ to _____ ft. What is the nearest source of possible contamination: [] Septic tank [] Sewer lines [] Watertight sewer lines [] Lateral lines [] Cess pool [] Seepage pit [] Pit privy [] Sewage lagoon [] Feedyard [] Livestock pens [X] Fuel Storage [] Fertilizer storage [] Insecticide storage [] Abandoned water well [] Oil well/Gas well [] Other (specify below) _____ Direction from well? _____ How many feet? _____

Table with 6 columns: FROM, TO, PLUGGING MATERIALS, FROM, TO, PLUGGING MATERIALS. Row 1: 0, 3, Top Soil. Row 2: 3, 20, Bentonite.

7 CONTRACTOR'S OR LANDOWNER'S CERTIFICATION: This water well was plugged under my jurisdiction and was completed on (mo/day/year) 09/26/2014 and this record is true to the best of my knowledge and belief. Kansas Water Well Contractor's License No. 710. This Water Well Record was completed on (mo/day/year) 09/26/2014 under the business name of Below Ground Surface, Inc. by (signature) [Signature]

INSTRUCTIONS: Use typewriter or ballpoint pen. Please press firmly and print clearly. Please fill in blanks, underline or circle the correct answers. Send one copy to Kansas Department of Health and Environment, Bureau of Water, Geology Section, 1000 SW Jackson St., Ste. 420, Topeka, Kansas 66612-1367. Telephone: 785/296-5524. Send one to Water Well Owner and retain one for your records. Visit us at http://www.kdheks.gov/waterwell/index.html.