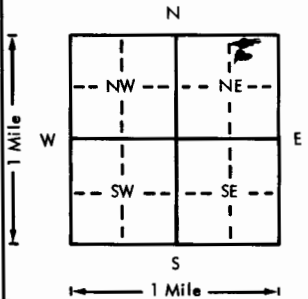


USE TYPEWRITER OR BALL
POINT PEN-PRESS FIRMLY,
PRINT CLEARLY.

WATER WELL RECORD
KSA 82a-1201-1215

Kansas Department of Health and
Environment-Division of Environment
(Water well Contractors)
Topeka, Kansas 66620

1. Location of well:		County <u>Harvey</u>	Fraction <u>NW 1/4 NE 1/4 NE 1/4</u>	Section number <u>8</u>	Township number <u>T 23</u>	Range number <u>S R 2</u>	<u>EW</u>
2. Distance and direction from nearest town or city: <u>Walter, Ks. Coop - 1 1/2 East then 3 south - 1/4 West on So. side</u>				3. Owner of well: <u>Edwin Regier</u> R.R. or street: <u>R4</u> City, state, zip code: <u>Newton Kansas</u>			
4. Locate with "X" in section below:		Sketch map:		6. Bore hole dia. <u>8 to 10</u> . Completion date <u>Feb 11-77</u> Well depth <u>73</u> ft.			
				7. <input checked="" type="checkbox"/> Cable tool <input type="checkbox"/> Rotary <input type="checkbox"/> Driven <input type="checkbox"/> Dug <input type="checkbox"/> Hollow rod <input type="checkbox"/> Jetted <input type="checkbox"/> Bored <input type="checkbox"/> Reverse rotary			
5. Type and color of material		From		To		8. Use: <input checked="" type="checkbox"/> Domestic <input checked="" type="checkbox"/> Public supply <input type="checkbox"/> Industry <input type="checkbox"/> Irrigation <input type="checkbox"/> Air conditioning <input type="checkbox"/> Stock <input type="checkbox"/> Lawn <input type="checkbox"/> Oil field water <input type="checkbox"/> Other	
<u>Topsail</u>		<u>4</u>		<u>2</u>		9. Casing: Material <u>Plastic</u> Height: (Above or below) Threaded <input type="checkbox"/> Welded <input checked="" type="checkbox"/> Surface <u>24</u> in. RMP <input checked="" type="checkbox"/> PVC <input type="checkbox"/> Weight <u>200</u> lbs./ft. Dia. <u>6</u> in. to <u>13</u> ft. depth Wall Thickness: inches or Dia. <u>6</u> in. to <u>13</u> ft. depth gauge No. <u>2/10</u>	
<u>Blue shale</u>		<u>2</u>		<u>5</u>		10. Screen: Manufacturer's name <u>Superflow</u> <u>Elastic P-10 inc</u> Type <u>RMP</u> Dia. <u>6</u> Slot/gauze <u>3/32</u> Length <u>55 ft</u> Set between <u>13</u> ft. and <u>68</u> ft. ft. and <u>68</u> ft. Gravel pack? <input checked="" type="checkbox"/> Size range of material <u>4 to 10</u>	
<u>gray clay</u>		<u>5</u>		<u>8</u>		11. Static water level: <u>12</u> ft. below land surface Date <u>Feb 11 77</u> mo./day/yr.	
<u>Rock</u>		<u>8</u>		<u>20</u>		12. Pumping level below land surfaces: <u>12</u> ft. after <u>0</u> hrs. pumping <u>10</u> g.p.m. ft. after <u> </u> hrs. pumping <u> </u> g.p.m. Estimated maximum yield <u>2 g. per min</u> g.p.m.	
<u>Blue Shale</u>		<u>20</u>		<u>30</u>		13. Water sample submitted: <u> </u> mo./day/yr. Yes <input checked="" type="checkbox"/> No <input type="checkbox"/> Date <u> </u>	
<u>Limestone</u>		<u>30</u>		<u>32</u>		14. Well head completion: <u> </u> Pitless adapter <u>24</u> inches above grade	
<u>Blue Shale</u>		<u>32</u>		<u>73</u>		15. Well grouted? <input checked="" type="checkbox"/> With: <input checked="" type="checkbox"/> Neat cement <input checked="" type="checkbox"/> Bentonite <input type="checkbox"/> Concrete Depth: From <u>3</u> ft. to <u>12</u> ft.	
						16. Nearest source of possible contamination: <input checked="" type="checkbox"/> <u>20 rods</u> Direction <u>So.</u> Type <u>Pond</u> Well disinfected upon completion? <input checked="" type="checkbox"/> Yes <input type="checkbox"/> No	
						17. Pump: <input checked="" type="checkbox"/> Not installed Manufacturer's name <u> </u> Model number <u> </u> HP <u> </u> Volts <u> </u> Length of drop pipe <u> </u> ft. capacity <u> </u> g.p.m. Type: <u> </u> Submersible <u> </u> Turbine <u> </u> Jet <u> </u> Reciprocating <u> </u> Centrifugal <u> </u> Other	
						20. Water well contractor's certification: This well was drilled under my jurisdiction and this report is true to the best of my knowledge and belief. <u>Terom Buddle 221</u> Business name <u>R Newton Kansas</u> License No. <u> </u> Address <u> </u> Signed <u>Terom Buddle</u> Date <u>2/16/77</u> Authorized representative	
18. Elevation:		19. Remarks:					
Topography: <input checked="" type="checkbox"/> Hill <input type="checkbox"/> Slope <input type="checkbox"/> Upland <input type="checkbox"/> Valley							