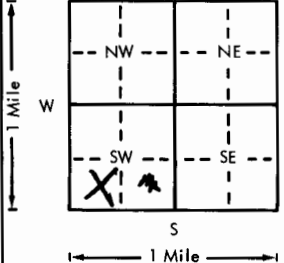
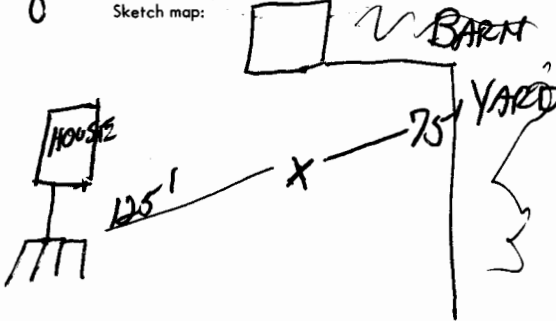


USE TYPEWRITER OR BALL  
POINT PEN-PRESS FIRMLY,  
PRINT CLEARLY.

WATER WELL RECORD  
KSA 82a-1201-1215

Kansas Department of Health and  
Environment-Division of Environment  
(Water well Contractors)  
Topeka, Kansas 66620

1. Location of well: <b>Harvey</b>		County <b>Harvey</b>		Fraction <b>SE 1/4 SW 1/4 SW 1/4</b>		Section number <b>34</b>		Township number <b>T 23</b>		Range number <b>S 2 E E/W</b>	
2. Distance and direction from nearest town or city: <b>2 N - 2 1/2 W of Whitewater</b>				3. Owner of well: <b>Melvin L Klaassen</b> R.R. or street: <b>Rt 2</b> City, state, zip code: <b>Whitewater Kansas</b>							
4. Locate with "X" in section below: 				Sketch map: 				6. Bore hole dia. <b>8</b> in. Completion date <b>5-9-78</b> Well depth <b>69</b> ft.			
5. Type and color of material				From		To		7. <input checked="" type="checkbox"/> Cable tool <input checked="" type="checkbox"/> Rotary <input type="checkbox"/> Driven <input type="checkbox"/> Dug <input type="checkbox"/> Hollow rod <input type="checkbox"/> Jetted <input type="checkbox"/> Bored <input type="checkbox"/> Reverse rotary			
								8. Use: <input checked="" type="checkbox"/> Domestic <input checked="" type="checkbox"/> Public supply <input type="checkbox"/> Industry <input type="checkbox"/> Irrigation <input type="checkbox"/> Air conditioning <input type="checkbox"/> Stock <input type="checkbox"/> Lawn <input type="checkbox"/> Oil field water <input type="checkbox"/> Other			
								X Casing: Material <b>Plast</b> Height: Above or below Threaded <input type="checkbox"/> Welded <input checked="" type="checkbox"/> Surface <b>24</b> in. RMP <b>XX</b> <input checked="" type="checkbox"/> C Weight <b>10</b> lbs./ft. Dia. <b>5</b> in. to <b>6 1/2</b> ft. depth Wall Thickness: inches or Dia. <b>5</b> in. to <b>6 1/2</b> ft. depth Gauge No. <b>200</b>			
								10. Screen: Manufacturer's name <b>Sunflower Plastic Pipe</b> Type <b>200</b> Dia. <b>5 in</b> Slot/gauze <b>20 ft</b> Length <b>20 ft</b> Set between <b>49</b> ft. and <b>69</b> ft. Gravel pack? <b>yes</b> Size range of material <b>1/8 in</b>			
								11. Static water level: <b>45</b> ft. below land surface Date <b>4-25-78</b> 12. Pumping level below land surfaces: ____ ft. after ____ hrs. pumping ____ g.p.m. ____ ft. after ____ hrs. pumping ____ g.p.m. Estimated maximum yield ____ g.p.m.			
								13. Water sample submitted: ____ mo./day/yr. ____ Yes <input checked="" type="checkbox"/> No Date ____			
								14. Well head completion: <input checked="" type="checkbox"/> Pitless adapter <b>18</b> inches above grade			
								15. Well grouted? <b>yes</b> With: ____ Neat cement ____ Bentonite <b>XX</b> Concrete Depth: From <b>4</b> ft. to <b>14</b> ft.			
								16. Nearest source of possible contamination: ft. <b>75</b> Direction <b>NE</b> Type <b>BARN YARD</b> Well disinfected upon completion? <input checked="" type="checkbox"/> Yes ____ No			
								17. Pump: ____ Not installed Manufacturer's name <b>GOULDS</b> Model number <b>10570714</b> HP <b>3/4</b> Volts <b>230</b> Length of drop pipe <b>65</b> ft. capacity <b>10</b> g.p.m. Type: <input checked="" type="checkbox"/> Submersible ____ Turbine ____ Jet ____ Reciprocating ____ Centrifugal ____ Other			
18. Elevation:				19. Remarks:				20. Water well contractor's certification: This well was drilled under my jurisdiction and this report is true to the best of my knowledge and belief. <b>MARTIN SUPPLY</b> <b>362</b> Business name License No. Address <b>500 W22nd. N. Newton Ks.</b> Signed <b>B. J. Abner</b> Date <b>6-26-78</b> Authorized representative			