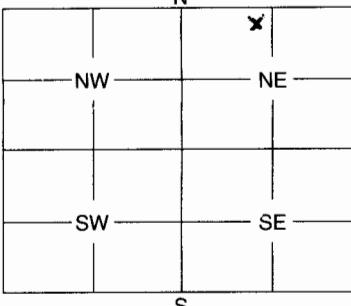


1	LOCATION OF WATER WELL: County: Butler	Fraction NE $\frac{1}{4}$ NE $\frac{1}{4}$	Section Number 4	Township Number T 26S	Range Number R 6E	E/W E
Distance and direction from nearest town or city street address of well if located within city? From El Dorado E 3 miles Blue Stream Rd N 1 mile $\frac{3}{4}$ E on Parallel 57						
2	WATER WELL OWNER: RR #, St. Address, Box #: City, State, ZIP Code : Stan Becker 3799 SE Parallel St El Dorado, KS 67042	Board of Agriculture, Division of Water Resources Application Number:				
3	MARK WELL'S LOCATION WITH AN "X" IN SECTION BOX: 	4	DEPTH OF WELL 105' ft.			
			WELL'S STATIC WATER LEVEL 30 ft.			
			WELL WAS USED AS:			
			1 Domestic	5 Public Water Supply	9 Dewatering	
			2 Irrigation	6 Oil Field Water Supply	10 Monitoring Well	
			3 Feedlot	7 Domestic (Lawn & Garden)	11 Injection Well	
			4 Industrial	8 Air Conditioning	12 Other	
			Was a chemical / bacteriological sample submitted to Department? Yes No X If yes, mo/day/yr sample was submitted			
			Water Well Disinfected: Yes X No			
5	TYPE OF BLANK CASING USED:					
	1 Steel	3 RMP (SR)	5 Wrought	7 Fiberglass	9 Other (Specify below)	
	2 PVC	4 ABS	6 Asbestos-Cement	8 Concrete Tile	
	Blank casing diameter 8 in. Was casing pulled? Yes No X If yes, how much					
	Casing height above or <u>below</u> land surface 6' in.					
6	GROUT PLUG MATERIAL: 1 Neat cement 2 Cement grout 3 Bentonite 4 Other					
	Grout Plug Intervals: From 18' ft. to ft., From 25' ft. to ft., From to ft.					
	What is the nearest source of possible contamination:					
	1 Septic tank	6 Seepage pit	11 Fuel storage	16 Other (specify below)		
	2 Sewer lines	7 Pit privy	12 Fertilizer storage		
	3 Watertight sewer lines	8 Sewage lagoon	13 Insecticide storage		
	4 Lateral lines	9 Feedyard	14 Abandoned water well		
	5 Cess pool	10 Livestock pens	15 Oil well/Gas well		
	Direction from well? WEST How many feet? 75					
	FROM	TO	PLUGGING MATERIALS			
	105'	25'	Pea Gravel			
	25	18	Bentonite			
	18'	6'	neat cement			
7	CONTRACTOR'S OF LANDOWNER'S CERTIFICATION: This water well was plugged under my jurisdiction and was completed on (mo/day/year) Nov. 13² 98 and this record is true to the best of my knowledge and belief. Kansas Water Well Contractor's License No. 739 This Water Well Record was completed on (mo/day/year) under the business name of Fluid Tech Seal / Fluid System by (signature) Charles I. Peeler					
INSTRUCTIONS: Use typewriter or ball point pen. Please press firmly and print clearly. Please fill in blanks, underline or circle the correct answers. Send top three copies to Kansas Department of Health and Environment, Bureau of Water, Geology Section, 1000 SW Jackson St., Ste. 420, Topeka, Kansas 66612-1367. Telephone: 785/296-5522. Send one to Water Well Owner and retain one for your records.						