


CLARKE WELL & EQUIPMENT, INC.

WELL RECORD DESIGN & CONSTRUCTION SHEET



JOB NUMBER 3679
 WELL OWNER City of Wichita WELL NO. DMW-H1
 WELL USE Monitor Well APPROPRIATION NO.
 LOCATION SE 1/4 SE 1/4 SW 1/4, SECTION NO. 29
T 23 S, R 2 W/E Harvey COUNTY Kansas
40 FSL, 3040 FEL State

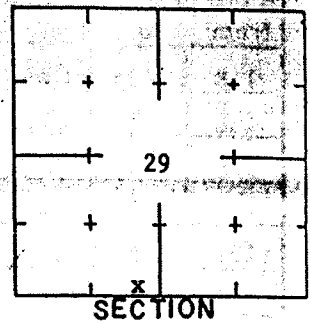

SIZE HOLE 6 "DIA.
 SIZE CASING 2 " DIA. .218 WALL; WT. .96 LBS/FT PVC MATERIAL
 SIZE SCREEN 2 " DIA. .218 WALL PVC MATERIAL .030 M111 SLOT/NOSE

FORMATION LOG. From test no. from to			Formation Thickness	From ground level	From	To	Ftg.
0	6	Topfill		Casing	0	198	198
6	14	Clay, tannish-brown		Screen	198	208	10
14	27	Sand and gravel, medium and fine					
27	34	Clay, dark gray, hard					
34	35	Sand, medium, fine					
35	42	Clay, dark gray, hard					
42	44	Clay, brown, soft					
44	45	Sand, medium and fine					
45	47	Clay, brown, soft					
47	51	Sand, medium and fine					
51	53	Sand, medium and fine					
53	61	Clay, green, hard					
61	84	Sand, medium and fine					
84	97	Sand, medium and fine					
97	101	Clay, green, hard					
101	118	Sand, medium and fine		CASING LEFT ABOVE GROUND			2
		CONTINUED ON BACK SIDE		TOTAL CASING & SCREEN			210

STATIC WATER LEVEL 63.10 CHLORINATE None QUANTITY USED
 From ground level

GRAVEL PACK ANNULAR SEAL
196 TO 220 0 TO 196 Bentonite Holeplug
 TO TO

WHAT IS THE NEAREST SOURCE OF POSSIBLE CONTAMINATION None known
 DIRECTION FROM WELL HOW MANY FEET
 DESIGNED BY DRILLED BY Edward Cass DATE 4-30-97

Continued : formation log data

[illegible]