


CLARKE WELL & EQUIPMENT, INC.

WELL RECORD DESIGN & CONSTRUCTION SHEET



JOB NUMBER 3679
 WELL OWNER City of Wichita WELL NO. DMW-H7
 WELL USE Monitor APPROPRIATION NO. _____
 LOCATION SE 1/4 SE 1/4 SW 1/4, SECTION NO. 29
 T 23 S, R 2 W/E Harvey COUNTY Kansas
365 FSL, 2865 FEL State

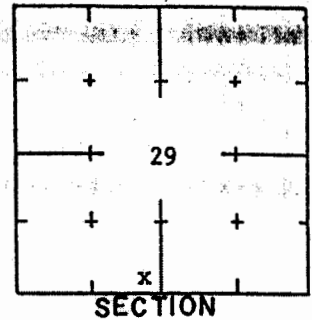

SIZE HOLE 6 "DIA.
 SIZE CASING 2 " DIA. .218 WALL; WT. .96 LBS/FT PVC MATERIAL
 SIZE SCREEN 2 " DIA. .218 WALL PVC MATERIAL .030 M111 SLOT/NOSE

FORMATION LOG. From test no. from to			Formation Thickness	From ground level	From	To	Ftg.
0	3	Topsoil		Casing	0	187	187
3	9	Clay, brown, hard		Screen	187	197	10
9	27	Sand and gravel, coarse, medium, fine					
27	53	Clay, dark gray, hard					
53	68	Sand, medium and fine					
68	87	Clay, green and brown, soft					
87	94	Sand, medium and fine					
94	111	Clay, dark gray and tan, hard					
111	127	Clay, green and tan, soft					
127	128	Sand, medium and fine					
128	134	Clay, green and tan, hard					
134	137	Sand, medium and fine					
137	146	Clay, tan, soft					
146	170	Sand, medium and fine					
170	181	Clay, gray and black, soft		CASING LEFT ABOVE GROUND			2
		CONTINUED ON BACK SIDE		TOTAL CASING & SCREEN			199

STATIC WATER LEVEL 48.85 CHLORINATE none QUANTITY USED
 From ground level

GRAVEL PACK ANNULAR SEAL
185 TO 220 0 TO 185 Bentonite Holeplug
 TO TO

WHAT IS THE NEAREST SOURCE OF POSSIBLE CONTAMINATION None known
 DIRECTION FROM WELL _____ HOW MANY FEET _____
 DESIGNED BY _____ DRILLED BY Edward Cass DATE 5-6-97

Continued : formation log data

[illegible]