


CLARKE WELL & EQUIPMENT, INC.

WELL RECORD DESIGN & CONSTRUCTION SHEET



JOB NUMBER 3679
 WELL OWNER City of Wichita WELL NO. DMW-H10
 WELL USE Monitor APPROPRIATION NO.
 LOCATION SE 1/4 SE 1/4 SW 1/4, SECTION NO. 29
 T 23 S, R 2 W/E Harvey COUNTY Kansas
40 FSL, 2845 FEL State

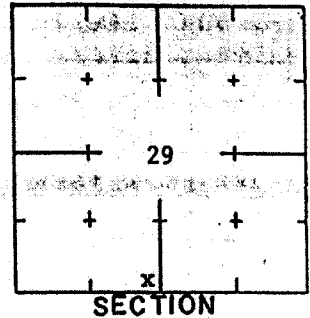

SECTION

SIZE HOLE 6 "DIA.
 SIZE CASING 2 " DIA. .218 WALL; WT. .96 LBS/FT PVC MATERIAL
 SIZE SCREEN 2 " DIA. .218 WALL PVC MATERIAL .030 M111 SLOT/ROD

FORMATION LOG. From test no. from to			Formation Thickness	From ground level	From	To	Ftg.
0	4	Topfill		Casing	0	188	188
4	13	Clay, brown, hard		Screen	188	198	10
13	31	Sand and gravel, coarse, medium, fine					
31	52	Clay, gray, hard					
52	63	Clay, green, hard					
63	69	Sand, medium and fine					
69	83	Clay, green and tan, soft					
83	97	Sand, medium and fine					
97	102	Clay, green, soft					
102	131	Clay, white, soft					
131	139	Clay, green and brown, hard					
139	141	Sand, medium and fine					
141	146	Clay, white, soft					
146	169	Sand, medium and fine					
169	172	Clay, white, soft		CASING LEFT ABOVE GROUND			2
		CONTINUED ON BACK SIDE		TOTAL CASING & SCREEN			200

STATIC WATER LEVEL 53.42 CHLORINATE None QUANTITY USED
 From ground level

GRAVEL PACK ANNULAR SEAL
186 TO 220 0 TO 186 Bentonite Holeplug
 TO TO

WHAT IS THE NEAREST SOURCE OF POSSIBLE CONTAMINATION None known
 DIRECTION FROM WELL HOW MANY FEET
 DESIGNED BY DRILLED BY Edward Cass DATE 5-7-97

Continued : formation log data

[illegible]