


# CLARKE WELL & EQUIPMENT, INC.

## WELL RECORD DESIGN & CONSTRUCTION SHEET

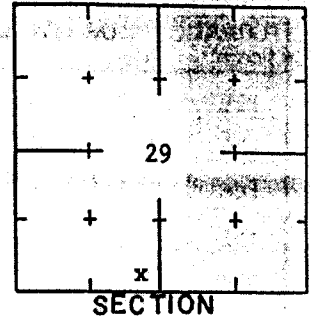

JOB NUMBER 3679  
 WELL OWNER City of Wichita WELL NO. H2  
 WELL USE Piezometer APPROPRIATION NO.           
 LOCATION SE 1/4 SE 1/4 SW 1/4, SECTION NO. 29  
 T 23 S, R 2 W/E Harvey COUNTY Kansas  
157 FSL, 3234 FEL State

SIZE HOLE 6 "DIA.  
 SIZE CASING 2 " DIA. .218 WALL; WT. .96 LBS/FT PVC MATERIAL  
 SIZE SCREEN 2 " DIA. .218 WALL PVC MATERIAL .030 M111 SLOT/NOSE

FORMATION LOG. From test no. from to			Formation Thickness	From ground level	From	To	Fig.
0	4	Topsoil		Casing	0	163	163
4	11	Clay, brown		Screen	163	173	10
11	27	Sand and gravel, coarse, medium, fine					
27	31	Clay, black, hard					
31	38	Clay, gray, hard					
38	46	Clay, black, hard					
46	57	Clay, gray, hard					
57	67	Sand, medium, fine					
67	77	Clay, green, soft					
77	84	Sand, medium and fine					
84	89	Clay, green, soft					
89	99	Sand, medium, fine					
99	101	Clay, tan, soft					
101	115	Sand, medium and fine					
115	119	Clay, green, soft		CASING LEFT ABOVE GROUND			2
		CONTINUED ON BACK SIDE		TOTAL CASING & SCREEN			175

STATIC WATER LEVEL 45.8' FGL (6-12-97) CHLORINATE none QUANTITY USED  
 From ground level

GRAVEL PACK ANNULAR SEAL  
161 TO 182 0 TO 161 Bentonite Holeplug  
         TO                   TO         

WHAT IS THE NEAREST SOURCE OF POSSIBLE CONTAMINATION None known  
 DIRECTION FROM WELL          HOW MANY FEET           
 DESIGNED BY          DRILLED BY Edward Cass DATE 5-22-97

## Continued : formation log data

[illegible]