


CLARKE WELL & EQUIPMENT, INC.

WELL RECORD

DESIGN & CONSTRUCTION SHEET



JOB NUMBER 3679
 WELL OWNER City of Wichita WELL NO. H3
 WELL USE Piezometer APPROPRIATION NO. _____
 LOCATION SW 1/4 SE 1/4 SW 1/4 SECTION NO. 29
 T 23 S, R 2 W/E Harvey COUNTY Kansas
164 FSL, 3435 FEL State

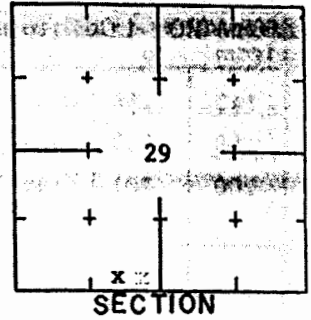

SIZE HOLE 6 "DIA.
 SIZE CASING 2 " DIA. .218 WALL; WT. .96 LBS/FT PVC MATERIAL
 SIZE SCREEN 2 " DIA. .218 WALL PVC MATERIAL .030 Mill SLOT/PISTON

FORMATION LOG. From test no.			Formation Thickness	From ground level	From	To	Fig.
from	to						
0	4	Topsoil		Casing	0	178	178
4	12	Clay, brown		Screen	178	188	10
12	26	Sand and gravel, coarse, medium, fine					
26	42	Clay, black, hard					
42	61	Clay, gray					
61	64	Sand, medium, fine					
64	77	Clay, gray and black					
77	87	Clay, white					
87	96	Sand, medium and fine					
96	104	Clay, green					
104	105	Sand, medium, fine					
105	131	Clay, gray and black					
131	140	Sand, medium, fine					
140	143	Clay, green					
143	145	Sand, medium, fine		CASING LEFT ABOVE GROUND			2
		CONTINUED ON BACK SIDE		TOTAL CASING & SCREEN			190

STATIC WATER LEVEL 185' FGL (6-13-97) CHLORINATE None QUANTITY USED _____
 From ground level

GRAVEL PACK ANNULAR SEAL
176 TO 200 0 TO 176 Bentonite Holeplug
 TO TO

WHAT IS THE NEAREST SOURCE OF POSSIBLE CONTAMINATION None known
 DIRECTION FROM WELL _____ HOW MANY FEET _____

DESIGNED BY _____ DRILLED BY Edward Cass DATE 5-21-97

Continued : formation log data

[illegible]