


CLARKE WELL & EQUIPMENT, INC.

WELL RECORD DESIGN & CONSTRUCTION SHEET

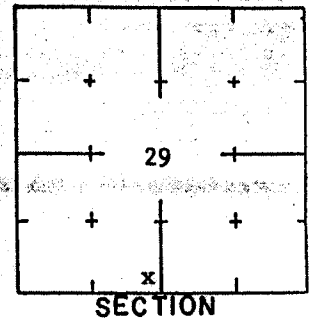

JOB NUMBER 3679
 WELL OWNER City of Wichita WELL NO. H5
 WELL USE Piezometer APPROPRIATION NO. _____
 LOCATION SE 1/4 SE 1/4 SW 1/4, SECTION NO. 29
 T 23 S, R 2 W/E Harvey COUNTY Kansas
195 FSL, 2936 FEL State

SIZE HOLE 6 "DIA.
 SIZE CASING 2 " DIA. .218 WALL; WT. .96 LBS/FT PVC MATERIAL
 SIZE SCREEN 2 " DIA. .218 WALL PVC MATERIAL .030 M111 SLOT/PISTON

FORMATION LOG. From test no. from to			Formation Thickness	From ground level	From	To	Fig.
0	3	Topsoil		Casing	0	154	154
3	7	Clay, dark brown		Screen	154	164	10
7	12	Clay, brown					
12	28	Sand and gravel, fine, medium, coarse, clean, loose					
28	36	Clay, gray					
36	39	Sand, fine with clay, gray mixed					
39	60	Clay, gray					
60	68	Sand, fine, medium					
68	80	Clay, gray					
80	90	Sand, fine, dirty					
90	118	Sand and gravel, fine, medium					
118	146	Clay, gray					
146	171	Sand and gravel, fine, medium					
171		Clay, green					
				CASING LEFT ABOVE GROUND			2
				TOTAL CASING & SCREEN			166

STATIC WATER LEVEL 50.50 CHLORINATE none QUANTITY USED
 From ground level

GRAVEL PACK ANNULAR SEAL
152 TO 171 0 TO 152 Bentonite Holeplug
 TO TO

WHAT IS THE NEAREST SOURCE OF POSSIBLE CONTAMINATION None known
 DIRECTION FROM WELL _____ HOW MANY FEET _____
 DESIGNED BY _____ DRILLED BY Maurice Schreck DATE 5-12-97