


CLARKE WELL & EQUIPMENT, INC.

WELL RECORD DESIGN & CONSTRUCTION SHEET



JOB NUMBER 3679
 WELL OWNER City of Wichita WELL NO. H6
 WELL USE Piezometer APPROPRIATION NO.
 LOCATION SE 1/4 SE 1/4 SW 1/4, SECTION NO. 29
 T 23 S, R 2 W/E Harvey COUNTY Kansas
285 FSL, 2936 FEL State

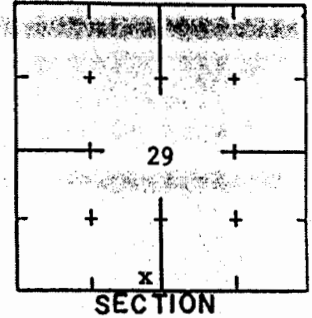

SIZE HOLE 6 "DIA.
 SIZE CASING 2 " DIA. .218 WALL; WT. .96 LBS/FT PVC MATERIAL
 SIZE SCREEN 2 " DIA. .218 WALL PVC MATERIAL .030 MILL SLOT/NO. 2

FORMATION LOG. From test no. from to			Formation Thickness	From ground level	From	To	Ftg.
0	5	Topsoil		Casing	0	152	152
5	9	Clay, brown, hard		Screen	152	162	10
9	26	Sand and gravel, coarse, medium, and fine					
26	42	Clay, gray and black, hard					
42	52	Clay, brown and gray					
52	74	Clay, green, soft					
74	86	Clay, tan and green, hard					
86	98	Sand, medium and fine					
98	105	Clay, gray					
105	134	Clay, green and gray, hard					
134	139	Sand, medium and fine					
139	146	Clay, tan, soft					
146	169	Sand, medium and fine					
169	170	Clay, gray, hard					
				CASING LEFT ABOVE GROUND			2
				TOTAL CASING & SCREEN			164

STATIC WATER LEVEL 48.20 CHLORINATE none QUANTITY USED
 From ground level

GRAVEL PACK ANNULAR SEAL
150 TO 170 0 TO 150 Bentonite Holeplug
 TO TO

WHAT IS THE NEAREST SOURCE OF POSSIBLE CONTAMINATION None known
 DIRECTION FROM WELL HOW MANY FEET
 DESIGNED BY DRILLED BY Edward Cass DATE 5-12-97