


CLARKE WELL & EQUIPMENT, INC.

WELL RECORD DESIGN & CONSTRUCTION SHEET



JOB NUMBER 3679
 WELL OWNER City of Wichita WELL NO. H15
 WELL USE Piezometer Well APPROPRIATION NO.
 LOCATION SW 1/4 SW 1/4 SE 1/4, SECTION NO. 29
 T 23 S, R 2 W/E Harvey COUNTY Kansas
 FSL, FEL State

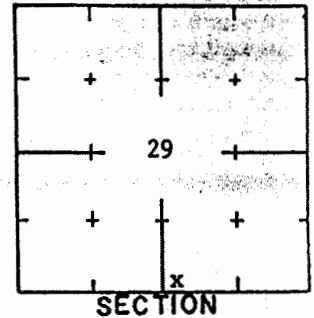

SIZE HOLE 6 "DIA.
 SIZE CASING 2 " DIA. .218 WALL; WT. .96 LBS/FT PVC MATERIAL
 SIZE SCREEN 2 " DIA. .218 WALL PVC MATERIAL .030 M111 SLOT/NOSE

FORMATION LOG. From test no. from to			Formation Thickness	From ground level	From	To	Fig.
0	1	Topsoil		Casing	0	129	129
1	3	Clay, very hard with tree roots		Screen	129	139	10
3	9	Clay, dark brown					
9	12	Clay, brown					
12	37	Sand and gravel, fine, medium					
37	51	Clay, gray					
51	61	Clay, gray to blue					
61	78	Sand and gravel, fine, medium					
78	83	Clay, green to blue					
83	97	Sand and gravel, medium, coarse					
97	114	Clay, green and tan with white					
114	154	Sand and gravel, fine, medium, coarse					
154	157	Clay, tan to white					
				CASING LEFT ABOVE GROUND			2
				TOTAL CASING & SCREEN			141

STATIC WATER LEVEL 49.01' FGL (6-12-97) CHLORINATE none QUANTITY USED
 From ground level

GRAVEL PACK 127 TO 145 ANNULAR SEAL 0 TO 127 Bentonite Holeplug
 TO 145 TO 157 Bentonite Holeplug

WHAT IS THE NEAREST SOURCE OF POSSIBLE CONTAMINATION None known
 DIRECTION FROM WELL HOW MANY FEET
 DESIGNED BY DRILLED BY Maurice Schreck DATE 5-22-97