


WELL RECORD
DESIGN & CONSTRUCTION SHEET

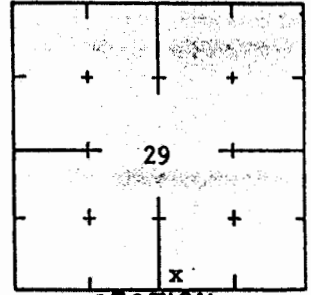

SIZE HOLE 6 "DIA.
SIZE CASING 2 " DIA. .154 WALL; WT. .70 LBS/FT PVC MATERIAL
SIZE SCREEN 2 " DIA. .154 WALL PVC MATERIAL .030 M111 SLOT/HOLE

GRAVEL PACK ANNULAR SEAL

19 TO 31.5 0 TO 19 Bentonite Holeplug

TO TO

WHAT IS THE NEAREST SOURCE OF POSSIBLE CONTAMINATION None known

DIRECTION FROM WELL HOW MANY FEET

DESIGNED BY DRILLED BY Edward Cass DATE 6-12-97