

WATER WELL PLUGGING RECORD Form WWC-5P

KSA 82a-1212

ID NO.

GW-20


1 LOCATION OF WATER WELL: Fraction NE $\frac{1}{4}$ SE $\frac{1}{4}$ SE $\frac{1}{4}$ Section Number 13 Township Number 23S Range Number 23 EW
 County: LINN

Distance and direction from nearest town or city street address of well if located within city?

6,700' South west of Mantey, KS

2 WATER WELL OWNER: Continental Coal Inc Global Positioning Systems (decimal degrees, min. of 4 digits)
 RR#, St. Address, Box #: 10801 Mastin Suite 920 Latitude: N 38.0409
 Overland Park KS Longitude: W 95.8238
 City, State ZIP Code: 66210 Elevation: ± 880
 Landowner: Milisa B. Sockow TRUST Datum: 1978 Mantey Kans USGS Quad
 Data Collection Method: Garmin GPS #72

3 MARK WELL'S LOCATION WITH AN "X" IN SECTION BOX:

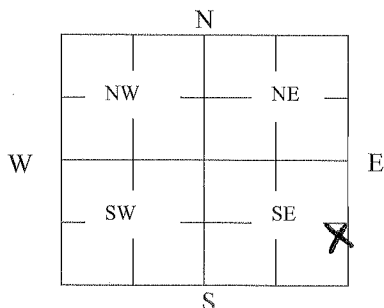

4 DEPTH OF WELL 42 ft.

WELL'S STATIC WATER LEVEL 33.5 ft

WELL WAS USED AS:

- | | | |
|--------------|----------------------------|-------------------|
| 1 Domestic | 5 Public Water Supply | 9 Dewatering |
| 2 Irrigation | 6 Oil Field Water Supply | 10 Monitoring |
| 3 Feedlot | 7 Domestic (Lawn & Garden) | 11 Injection Well |
| 4 Industrial | 8 Air Conditioning | 12 Other |

Was a chemical/bacteriological sample submitted to Department? Yes No X

5 TYPE OF BLANK CASING USED:

- | | | | | |
|---------|------------|-------------------|-----------------|-------------------------|
| 1 Steel | 3 RMP (SR) | 5 Wrought | 7 Fiberglass | 9 Other (Specify below) |
| 2 PVC | 4 ABS | 6 Asbestos-Cement | 8 Concrete Tile | |

Blank casing diameter 2 in. Was casing pulled? Yes X No If yes, how much 36"
 Casing height above or below land surface 36 in.

6 GROUT PLUG MATERIAL: 1 Neat cement 2 Cement grout 3 Bentonite 4 Other

Grout Plug Intervals: From 42.0 ft. to 3.0 ft., From ft. to ft., From to ft.

What is the nearest source of possible contamination:

- | | | | |
|--------------------------|-------------------|-------------------------|--------------------------------|
| 1 Septic tank | 6 Seepage pit | 11 Fuel Storage | 16 Other (specify below) |
| 2 Sewer lines | 7 Pit privy | 12 Fertilizer storage | |
| 3 Watertight sewer lines | 8 Sewage lagoon | 13 Insecticide storage | |
| 4 Lateral lines | 9 Feedyard | 14 Abandoned water well | Direction from well? Northeast |
| 5 Cess pool | 10 Livestock pens | 15 Oil well/Gas well | How many feet? 2500' |

FROM	TO	PLUGGING MATERIALS	FROM	TO	PLUGGING MATERIALS
42.0	3.0	Neat Cement			
3.0	0.0	Compacted Clay			

7 CONTRACTOR'S OR LANDOWNER'S CERTIFICATION: This water well was plugged under my jurisdiction and was completed on (mo/day/year) 11-4-2011 and this record is true to the best of my knowledge and belief. Kansas Water Well Contractor's License No. N/A This Water Well Record was completed on (mo/day/year) 12-2-2011 under the business name of TRIAD Env. Ser. Pittsburg, KS by (signature) James M. Bentley JAMES G. BENTLEY

INSTRUCTIONS: Use typewriter or ballpoint pen. Please press firmly and print clearly. Please fill in blanks, underline or circle the correct answers. Send top three copies to Kansas Department of Health and Environment, Bureau of Water, Geology Section, 1000 SW Jackson St., Ste. 420, Topeka, Kansas 66612-1367. Telephone: 785/296-5522. Send one to Water Well Owner and retain one for your records. Visit us at <http://www.kdheks.gov/geo/waterwells>.