

Distance and direction from nearest town or city street address of well if located within city?

6470 S SW Prescott


WATER WELL OWNER: Continental Coal
RR#, St. Address, Box #: 4550 W. 109th St., Ste. 206
City, State, ZIP Code: Leawood, KS. 66211

Board of Agriculture, Division of Water Resource:

Application Number:

844

LOCATE WELL'S LOCATION WITH AN "X" IN SECTION BOX:

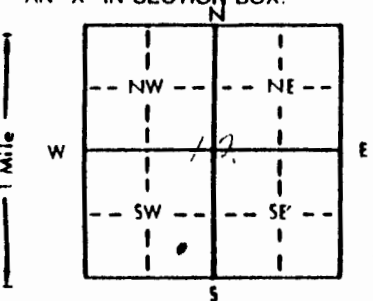

DEPTH OF COMPLETED WELL: 32 ft. ELEVATION: None

Depth(s) Groundwater Encountered: 1. None ft. 2. ft. 3. ft.

WELL'S STATIC WATER LEVEL: N/A ft. below land surface measured on mo/day/yr

Pump test data: Well water was N/A ft. after hours pumping gpm

Est. Yield gpm: Well water was 32 ft. after hours pumping gpm

Bore Hole Diameter: 5 in. to 32 ft. and in. to ft.

WELL WATER TO BE USED AS: 5 Public water supply 8 Air conditioning 11 Injection well

1 Domestic 3 Feedlot 6 Oil field water supply 9 Dewatering 12 Other (Specify below)

2 Irrigation 4 Industrial 7 Lawn and garden only 10 Monitoring well

Was a chemical/bacteriological sample submitted to Department? Yes No X If yes, mo/day/yr sample was submitted

Water Well Disinfected? Yes No X

TYPE OF BLANK CASING USED:

- 1 Steel 3 RMP (SR)
2 PVC 4 ABS

- 5 Wrought iron 8 Concrete tile
6 Asbestos-Cement 9 Other (specify below)

CASING JOINTS: Glued Clamped
Welded
Threaded

Blank casing diameter: 2 in. to 32 ft. Dia in. to ft. Dia in. to ft.

Casing height above land surface: in. weight Schedule 40 lbs./ft. Wall thickness or gauge No.

TYPE OF SCREEN OR PERFORATION MATERIAL:

- 1 Steel 3 Stainless steel
2 Brass 4 Galvanized steel

- 5 Fiberglass 8 RMP (SR)
6 Concrete tile 9 ABS

- 10 Asbestos-cement
11 Other (specify)
12 None used (open hole)

SCREEN OR PERFORATION OPENINGS ARE:

- 1 Continuous slot 3 Mill slot
2 Louvered shutter 4 Key punched

- 5 Gauzed wrapped 8 Saw cut 11 None (open hole)
6 Wire wrapped 9 Drilled holes
7 Torch cut 10 Other (specify)

SCREEN-PERFORATED INTERVALS: From 21 ft. to 32 ft. From ft. to ft.

From 18 ft. to 31 ft. From ft. to ft.

GRAVEL PACK INTERVALS: From ft. to ft. From ft. to ft.

From ft. to ft. From ft. to ft.

GROUT MATERIAL:

1 Neat cement

2 Cement grout

3 Bentonite

4 Other

Grout intervals: From 15 ft. to 0 ft. From 15 ft. to 18 ft. From ft. to ft.

What is the nearest source of possible contamination:

- 1 Septic tank 4 Lateral lines
2 Sewer lines 5 Cess pool
3 Watertight sewer lines 6 Seepage pit

7 Pit privy

8 Sewage lagoon

9 Feedyard

- 10 Livestock pens 14 Abandoned water well
11 Fuel storage 15 Oil well/Gas well
12 Fertilizer storage 16 Other (specify below)
13 Insecticide storage

Direction from well?

How many feet?

FROM TO		LITHOLOGIC LOG	FROM TO	PLUGGING INTERVALS
0	4	Top sub soil		
4	10	Red brown clay		
10	19	Gray/lt. brn shale		
19	22	Gray shale		
22	24.2	Coal		
24.2	27	Under clay		
27	32	Limestone		

RECEIVED

BUREAU OF WATER

CONTRACTOR'S OR LANDOWNER'S CERTIFICATION: This water well was (1) constructed, (2) reconstructed, or (3) plugged under my jurisdiction and was completed on (mo/day/year) 5-19-97 and this record is true to the best of my knowledge and belief. Kansas Water Well Contractor's License No. 545 This Water Well Record was completed on (mo/day/yr) under the business name of Glaze Drilling by (signature) *Libby Town for Allen L. Glaze*