

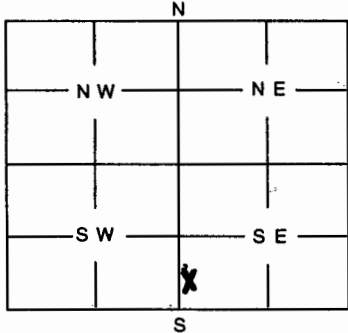
GW 17R

| | | | | | |
|---------|-------------------------|-------------------|----------------|-----------------|--------------|
| 1 | LOCATION OF WATER WELL: | Fraction | Section Number | Township Number | Range Number |
| County: | LINN | WAX SW 1/4 SE 1/4 | 12 | 23 S | 24 E |

Distance and direction from nearest town or city street address of well if located within city?

6470' South Southwest of Prescott, KS

| | | | |
|---------------------------|------------------------|---|------------------------|
| 2 | WATER WELL OWNER: | Continental Coal Inc | Karen German-Landowner |
| RR #, St. Address, Box #: | 10801 Mastin-Suite 920 | Board of Agriculture, Division of Water Resources | |
| City, State, ZIP Code : | Overland Park, KS 6620 | Application Number: | |

| | | | |
|--|--|---|---------------------------------|
| 3 | MARK WELL'S LOCATION WITH AN "X" IN SECTION BOX: | 4 | DEPTH OF WELL 26 ft |
|  | | WELL'S STATIC WATER LEVEL 13.2 ft. WELL WAS USED AS: 1 Domestic 5 Public Water Supply 9 Dewatering 2 Irrigation 6 Oil Field Water Supply 10 <u>Monitoring Well</u> 3 Feedlot 7 Domestic (Lawn & Garden) 11 Injection Well 4 Industrial 8 Air Conditioning 12 Other | |
| Was a chemical / bacteriological sample submitted to Department? Yes No <u>X</u> If yes, mo/day/yr sample was submitted | | | |
| Water Well Disinfected: Yes No <u>X</u> | | | |

| | |
|--|--|
| 5 | TYPE OF BLANK CASING USED: |
| 1 Steel | 3 RMP (SR) 5 Wrought 7 Fiberglass 9 Other (Specify below) |
| <u>2 PVC</u> | 4 ABS 6 Asbestos-Cement 8 Concrete Tile |
| Blank casing diameter <u>2</u> in. Was casing pulled? Yes <u>X</u> No If yes, how much <u>40" below</u> Casing height above or below land surface in. <u>ground level</u> | |

| | | | | | |
|--|----------------------|---------------|----------------|-------------|---------------|
| 6 | GROUT PLUG MATERIAL: | 1 Neat cement | 2 Cement grout | 3 Bentonite | 4 Other |
| Grout Plug Intervals: From <u>26</u> ft. to <u>3.0</u> ft., From ft. to ft., From to ft. | | | | | |
| What is the nearest source of possible contamination: 1 Septic tank 6 Seepage pit 11 Fuel storage 16 Other (specify below) 2 Sewer lines 7 Pit privy 12 Fertilizer storage <u>None</u> 3 Watertight sewer lines 8 Sewage lagoon 13 Insecticide storage 4 Lateral lines 9 Feedyard 14 Abandoned water well 5 Cess Pool 10 Livestock pens 15 Oil well/Gas well | | | | | |
| Direction from well? How many feet? | | | | | |

| FROM | TO | PLUGGING MATERIALS |
|-------|------|-------------------------|
| 26.0' | 3.0' | Neat Cement |
| 3.0' | 0.0' | Compacted Soil Material |
| | | |
| | | |
| | | |
| | | |
| | | |
| | | |

| | |
|---|--|
| 7 | CONTRACTOR'S OR LANDOWNER'S CERTIFICATION: This water well was plugged under my jurisdiction and was completed on (mo/day/year) <u>August 31, 2006</u> and this record is true to the best of my knowledge and belief. Kansas Water Well Contractor's License No. <u>N/A</u> This Water Well Record was completed on (mo/day/year) <u>September 12, 2006</u> under the business name of <u>Tripp Env. Ser. Pittsburg, KS</u> by (signature) <u>James M. Bentley</u> |
|---|--|

INSTRUCTIONS: Use typewriter or ball point pen. Please press firmly and print clearly. Please fill in blanks, underline or circle the correct answers. Send top three copies to Kansas Department of Health and Environment, Bureau of Water, Topeka, Kansas 66620-0001. Telephone: 785/296-3565. Send one to Water Well Owner and retain one for your records.