

WATER WELL PLUGGING RECORD Form WWC-5P

KSA 82a-1212

ID NO.

GW-5B

1 LOCATION OF WATER WELL: Fraction NE 1/4 NE 1/4 SE 1/4 Section Number 11 Township Number 23S Range Number 24 EW
 County: LINN

Distance and direction from nearest town or city street address of well if located within city?

11,710' W/SW of Prescott* KGS Waterwell Data BaseWATER WELL OWNER: Continental Coal, Inc

Global Positioning Systems (decimal degrees, min. of 4 digits)


RR#, St. Address, Box #:

10801 Martin - Suite 920Latitude: 38.06083* N 38° 03' 28.5" * *Longitude: -94.74297* W 094° 44' 02.3" * *

City, State ZIP Code:

Overland Park, KS 66210Elevation: 869* 869*Datum: * * And USGS QuadData Collection Method: ** BARMIN #72 GPS

3 MARK WELL'S LOCATION WITH AN "X" IN SECTION BOX:

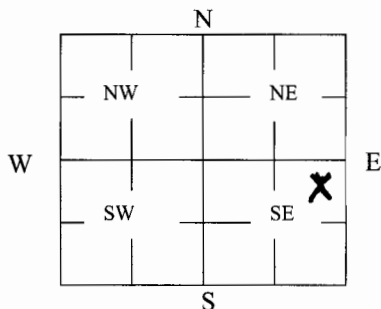

4 DEPTH OF WELL 67 ft.

WELL'S STATIC WATER LEVEL 33.4 ft Below ground

WELL WAS USED AS:

- 1 Domestic
2 Irrigation
3 Feedlot
4 Industrial

- 5 Public Water Supply
6 Oil Field Water Supply
7 Domestic (Lawn & Garden)
8 Air Conditioning

- 9 Dewatering
10 Monitoring
11 Injection Well
12 Other

Was a chemical/bacteriological sample submitted to Department? Yes No X

5 TYPE OF BLANK CASING USED:

1 Steel

3 RMP (SR)

5 Wrought

7 Fiberglass

9 Other (Specify below)

2 PVC

4 ABS

6 Asbestos-Cement

8 Concrete Tile

Blank casing diameter 2 in. Was casing pulled? Yes X No If yes, how much 40" below ground level

Casing height above or below land surface in.

GROUT PLUG MATERIAL:

1 Neat cement

2 Cement grout

3 Bentonite

4 Other

Grout Plug Intervals: From 67 ft. to 3.0 ft., From ft. to ft., From to ft.

What is the nearest source of possible contamination:

1 Septic tank

6 Seepage pit

11 Fuel Storage

16 Other (specify below)

2 Sewer lines

7 Pit privy

12 Fertilizer storage

3 Watertight sewer lines

8 Sewage lagoon

13 Insecticide storage

4 Lateral lines

9 Feedyard

14 Abandoned water well

Direction from well?

5 Cess pool

10 Livestock pens

15 Oil well/Gas well

How many feet?

Unknown

FROM	TO	PLUGGING MATERIALS	FROM	TO	PLUGGING MATERIALS
<u>67.0'</u>	<u>3.0'</u>	<u>Neat Cement</u>			
<u>3.0'</u>	<u>0.0'</u>	<u>Compacted Soil MATK</u>			

7 CONTRACTOR'S OR LANDOWNER'S CERTIFICATION: This water well was plugged under my jurisdiction and was completed on (mo/day/year) October 14, 2006 and this record is true to the best of my knowledge and belief. Kansas Water Well Contractor's License No. N/A. This Water Well Record was completed on (mo/day/year) 10/25/06 under the

Business name of TRIAD Env. Ser - Pittsburg, KS

by (signature)

James M. Bentley JAMES G. BENTLEY

INSTRUCTIONS: Use typewriter or ballpoint pen. Please press firmly and print clearly. Please fill in blanks, underline or circle the correct answers. Send top three copies to Kansas Department of Health and Environment, Bureau of Water, Geology Section, 1000 SW Jackson St., Ste. 420, Topeka, Kansas 66612-1367. Telephone: 785/296-5522. Send one to Water Well Owner and retain one for your records. Visit us at <http://www.kdheks.gov/geo/waterwells>.