

## WATER WELL PLUGGING RECORD Form WWC-5P

KSA 82a-1212

ID NO.

GW-4

1 LOCATION OF WATER WELL: Fraction SW 1/4 SW 1/4 SE 1/4 Section Number 11 Township Number 23S Range Number 24E  
 County: LINN

Distance and direction from nearest town or city street address of well if located within city?

13,800' West Southwest of Prescott\* KGS Waterwell Data BaseWATER WELL OWNER: Continental Coal, Inc

Global Positioning Systems (decimal) degrees, min. of 4 digits

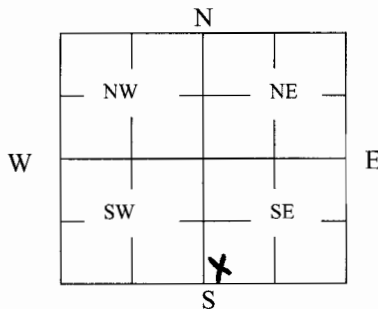
RR#, St. Address, Box #:

1001 Mastin - Suite 920  
Overland Park, KS  
66210Latitude: 38.05261 \* N 38° 03' 09.4" \*\*Longitude: -94.73953 \* W 94° 44' 25.4" \*\*Elevation: 830 \* 830 \*Datum: \* \* AND USGS QuadData Collection Method: \*\* GARMIN #72 GPS

City, State ZIP Code:

Landowner: Gordon Williams

3 MARK WELL'S LOCATION WITH AN "X" IN SECTION BOX:

4 DEPTH OF WELL 22 ft.WELL'S STATIC WATER LEVEL 10.9 ft Below Ground Level

WELL WAS USED AS:

1 Domestic

5 Public Water Supply

9 Dewatering

2 Irrigation

6 Oil Field Water Supply

10 Monitoring

3 Feedlot

7 Domestic (Lawn &amp; Garden)

11 Injection Well

4 Industrial

8 Air Conditioning

12 Other

Was a chemical/bacteriological sample submitted to Department? Yes    No X

5 TYPE OF BLANK CASING USED:

1 Steel

3 RMP (SR)

5 Wrought

7 Fiberglass

9 Other (Specify below)

2 PVC

4 ABS

6 Asbestos-Cement

8 Concrete Tile

Blank casing diameter 2 in. Was casing pulled? Yes X No    If yes, how much 40" belowCasing height above or below land surface    in. ground levelGROUT PLUG MATERIAL: 1 Neat cement 2 Cement grout 3 Bentonite 4 Other   Grout Plug Intervals: From 22.0 ft. to 3.0 ft., From    ft. to    ft., From    to    ft.

What is the nearest source of possible contamination:

1 Septic tank

6 Seepage pit

11 Fuel Storage

16 Other (specify below)

2 Sewer lines

7 Pit privy

12 Fertilizer storage

Unknown

3 Watertight sewer lines

8 Sewage lagoon

13 Insecticide storage

4 Lateral lines

9 Feedyard

14 Abandoned water well

Direction from well?   

5 Cess pool

10 Livestock pens

15 Oil well/Gas well

How many feet?   

FROM	TO	PLUGGING MATERIALS	FROM	TO	PLUGGING MATERIALS
<u>22.0'</u>	<u>3.0'</u>	<u>Neat Cement</u>			
<u>3.0'</u>	<u>0.0'</u>	<u>Compacted Soil Material</u>			

7 CONTRACTOR'S OR LANDOWNER'S CERTIFICATION: This water well was plugged under my jurisdiction and was completed on (mo/day/year) October 14, 2006 and this record is true to the best of my knowledge and belief. Kansas Water Well Contractor's License No. N/AThis Water Well Record was completed on (mo/day/year) October 25, 2006 by the business name of TRIAD ENV. Ser. Pittsburg, KS by (signature) James M. Bentley James G. BentleyINSTRUCTIONS: Use typewriter or ballpoint pen. Please press firmly and print clearly. Please fill in blanks, underline or circle the correct answers. Send top three copies to Kansas Department of Health and Environment, Bureau of Water, Geology Section, 1000 SW Jackson St., Ste. 420, Topeka, Kansas 66612-1367. Telephone: 785/296-5522. Send one to Water Well Owner and retain one for your records. Visit us at <http://www.kdheks.gov/geo/waterwells>.