

## WATER WELL PLUGGING RECORD Form WWC-5P

KSA 82a-1212

ID NO.

GW-18

1 LOCATION OF WATER WELL: Fraction SE 1/4 NE 1/4 NE 1/4 Section Number 18 Township Number 23S Range Number 24 EW  
 County: LINN

Distance and direction from nearest town or city street address of well if located within city?

700' South of Mantey, KS2 WATER WELL OWNER: Continental Coal Inc Global Positioning Systems (decimal degrees, min. of 4 digits)

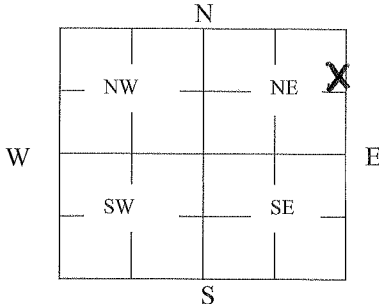
RR#, St. Address, Box #:

10801 Mastin, Suite 920  
Overland, Park, KS  
66210Latitude: N 38.0495Longitude: W 95.8066Elevation: ± 900

City, State ZIP Code:

Datum: 1978 MANTEY KANS USGS QUADData Collection Method: GARMIN GPS #72

3 MARK WELL'S LOCATION WITH AN "X" IN SECTION BOX:

4 DEPTH OF WELL 67.0 ft.WELL'S STATIC WATER LEVEL 37.8 ft

WELL WAS USED AS:

- 1 Domestic  
2 Irrigation  
3 Feedlot  
4 Industrial

- 5 Public Water Supply  
6 Oil Field Water Supply  
7 Domestic (Lawn & Garden)  
8 Air Conditioning

- 9 Dewatering  
10 Monitoring  
11 Injection Well  
12 Other

Was a chemical/bacteriological sample submitted to Department? Yes No X

5 TYPE OF BLANK CASING USED:

1 Steel

3 RMP (SR)

5 Wrought

7 Fiberglass

9 Other (Specify below)

2 PVC

4 ABS

6 Asbestos-Cement

8 Concrete Tile

Blank casing diameter 2 in. Was casing pulled? Yes X No If yes, how much 36"  
Casing height above or below land surface 36 in.6 GROUT PLUG MATERIAL: 1 Neat cement 2 Cement grout 3 Bentonite 4 OtherGrout Plug Intervals: From 67.0 ft. to 3.0 ft., From \_\_\_\_\_ ft. to \_\_\_\_\_ ft., From \_\_\_\_\_ to \_\_\_\_\_ ft.

What is the nearest source of possible contamination:

1 Septic tank

6 Seepage pit

11 Fuel Storage

16 Other (specify below)

2 Sewer lines

7 Pit privy

12 Fertilizer storage

3 Watertight sewer lines

8 Sewage lagoon

13 Insecticide storage

4 Lateral lines

9 Feedyard

14 Abandoned water well

Direction from well? North

5 Cess pool

10 Livestock pens

15 Oil well/Gas well

How many feet? ± 700'

FROM	TO	PLUGGING MATERIALS	FROM	TO	PLUGGING MATERIALS
<u>67.0</u>	<u>3.0</u>	<u>Neat Cement</u>			
<u>3.0</u>	<u>0.0</u>	<u>Compacted Soil MAT'L</u>			

7 CONTRACTOR'S OR LANDOWNER'S CERTIFICATION: This water well was plugged under my jurisdiction and was completed on (mo/day/year) 11-4-2011 and this record is true to the best of my knowledge and belief. Kansas Water Well Contractor's License No. N/A. This Water Well Record was completed on (mo/day/year) 12-2-2011 under the business name of TRIAD Env. Ser Pittsburg, KS by (signature) James G. Bentley JAMES G. BENTLEY

INSTRUCTIONS: Use typewriter or ballpoint pen. Please press firmly and print clearly. Please fill in blanks, underline or circle the correct answers. Send top three copies to Kansas Department of Health and Environment, Bureau of Water, Geology Section, 1000 SW Jackson St., Ste. 420, Topeka, Kansas 66612-1367. Telephone: 785/296-5522. Send one to Water Well Owner and retain one for your records. Visit us at <http://www.kdheks.gov/geo/waterwells>.