

WATER WELL PLUGGING RECORD Form WWC-5P

KSA 82a-1212

ID NO.

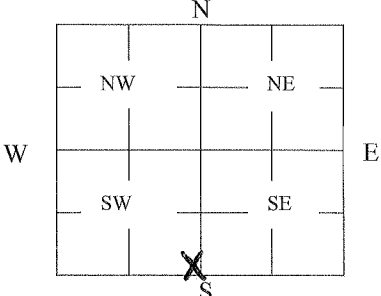
GW-19

| | | | | |
|--|---|-----------------------------|-------------------------------|-----------------------------|
| 1 LOCATION OF WATER WELL: County: <u>Linn</u> | Fraction <u>SE 1/4 SE 1/4 SW 1/4</u> | Section Number <u>18</u> | Township Number <u>23S</u> | Range Number <u>24 E</u> |
|--|---|-----------------------------|-------------------------------|-----------------------------|

Distance and direction from nearest town or city street address of well if located within city?

5,700 southwest of Mantey, KS

| | |
|--|---|
| 2 WATER WELL OWNER: <u>CONTINENTAL COAL</u> RR#, St. Address, Box #: <u>10801 MASTIN, Suite 920</u> <u>Overland Park, KS</u> City, State ZIP Code: <u>66210</u> <u>LANDOWNER: BRINKMAN TRUST</u> | Global Positioning Systems (decimal degrees, min. of 4 digits) Latitude: <u>N 38.0377</u> Longitude: <u>W 94.8151</u> Elevation: <u>+847</u> Datum: <u>1978 MANTHEY KANS USGS QUAD</u> Data Collection Method: <u>GARMIN GPS #72</u> |
|--|---|

| | |
|--|---|
| 3 MARK WELL'S LOCATION WITH AN "X" IN SECTION BOX:  | 4 DEPTH OF WELL <u>17.0</u> ft. WELL'S STATIC WATER LEVEL <u>10.8</u> ft. WELL WAS USED AS: 1 Domestic 5 Public Water Supply 9 Dewatering 2 Irrigation 6 Oil Field Water Supply 10 Monitoring 3 Feedlot 7 Domestic (Lawn & Garden) 11 Injection Well 4 Industrial 8 Air Conditioning 12 Other _____ Was a chemical/bacteriological sample submitted to Department? Yes _____ No <u>X</u> |
|--|---|

| | |
|---|--|
| 5 TYPE OF BLANK CASING USED: 1 Steel 3 RMP (SR) 5 Wrought 7 Fiberglass 9 Other (Specify below) <u>2 PVC</u> 4 ABS 6 Asbestos-Cement 8 Concrete Tile | Blank casing diameter <u>2</u> in. Was casing pulled? Yes <u>X</u> No _____ If yes, how much <u>36"</u> Casing height above or below land surface <u>36</u> in. |
|---|--|

| |
|--|
| 6 GROUT PLUG MATERIAL: <u>1 Neat cement</u> 2 Cement grout 3 Bentonite 4 Other _____ |
| Grout Plug Intervals: From <u>17.0</u> ft. to <u>3.0</u> ft., From _____ ft. to _____ ft., From _____ to _____ ft. |
| What is the nearest source of possible contamination: 1 <u>Septic tank</u> 6 Seepage pit 11 Fuel Storage 16 Other (specify below) 2 Sewer lines 7 Pit privy 12 Fertilizer storage 3 Watertight sewer lines 8 Sewage lagoon 13 Insecticide storage 4 Lateral lines 9 Feedyard 14 Abandoned water well 5 Cess pool 10 Livestock pens 15 Oil well/Gas well |
| Direction from well? <u>North (Mantey)</u> How many feet? <u>± 5,700'</u> <u>3,700' Northwest to Cochran House</u> |

| FROM | TO | PLUGGING MATERIALS | FROM | TO | PLUGGING MATERIALS |
|------|-----|----------------------|------|----|--------------------|
| 17.0 | 3.0 | Neat Cement | | | |
| 3.0 | 0.0 | Compacted Soil MAT'L | | | |
| | | | | | |
| | | | | | |
| | | | | | |
| | | | | | |
| | | | | | |

7 CONTRACTOR'S OR LANDOWNER'S CERTIFICATION: This water well was plugged under my jurisdiction and was completed on (mo/day/year) 11-4-2011 and this record is true to the best of my knowledge and belief. Kansas Water Well Contractor's License No. N/A. This Water Well Record was completed on (mo/day/year) 12-2-2011 under the business name of TRIAD Env. Ser. Pittsburg KS by (signature) James M. Bentley JAMES G. BENITEY

INSTRUCTIONS: Use typewriter or ballpoint pen. Please press firmly and print clearly. Please fill in blanks, underline or circle the correct answers. Send top three copies to Kansas Department of Health and Environment, Bureau of Water, Geology Section, 1000 SW Jackson St., Ste. 420, Topeka, Kansas 66612-1367. Telephone: 785/296-5522. Send one to Water Well Owner and retain one for your records. Visit us at <http://www.kdheks.gov/geo/waterwells>.