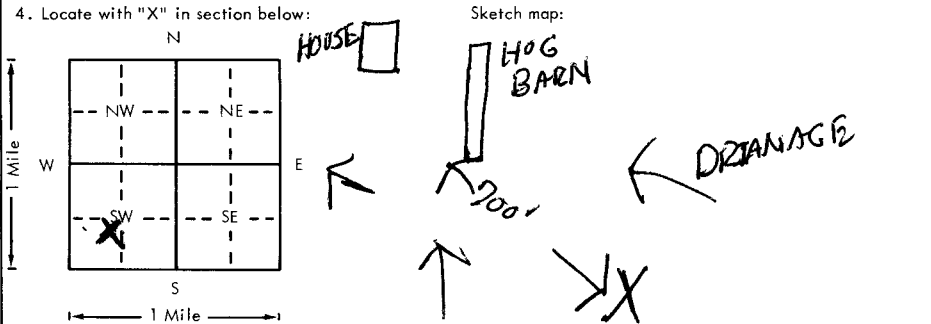


USE TYPEWRITER OR BALL POINT PEN-PRESS FIRMLY, PRINT CLEARLY.

WATER WELL RECORD
KSA 82a-1201-1215

Kansas Department of Health and Environment-Division of Environment
(Water well Contractors)
Topeka, Kansas 66620

1. Location of well:		County BUTLER	Fraction NE 1/4 SW 1/4 SW 1/4	Section number 8	Township number T 23 S	Range number R 3 E	0 <small>EW</small>																											
2. Distance and direction from nearest town or city: FROM EMBING Street address of well location in city: 1/2 W 1/4 N				3. Owner of well: ERWIN BUSIENITZ R.R. or street: RFD #3 City, state, zip code: EMBING KANS.																														
4. Locate with "X" in section below: 				6. Bore hole dia. 8 in. Completion date 9-20-28 Well depth 63 ft.																														
5. Type and color of material				7. <input type="checkbox"/> Cable tool <input checked="" type="checkbox"/> Rotary <input type="checkbox"/> Driven <input type="checkbox"/> Dug <input type="checkbox"/> Hollow rod <input type="checkbox"/> Jetted <input type="checkbox"/> Bored <input type="checkbox"/> Reverse rotary																														
				8. Use: <input checked="" type="checkbox"/> Domestic <input type="checkbox"/> Public supply <input type="checkbox"/> Industry <input type="checkbox"/> Irrigation <input type="checkbox"/> Air conditioning <input type="checkbox"/> Stock <input type="checkbox"/> Lawn <input type="checkbox"/> Oil field water <input type="checkbox"/> Other																														
<table border="1" style="width:100%; border-collapse: collapse;"> <thead> <tr> <th style="width:80%;"></th> <th style="width:10%;">From</th> <th style="width:10%;">To</th> </tr> </thead> <tbody> <tr> <td>TOP PART</td> <td>0</td> <td>2</td> </tr> <tr> <td>B LIGHT BROWN CLAY</td> <td>2</td> <td>25</td> </tr> <tr> <td>LIGHT BLUE SHALE</td> <td>25</td> <td>25</td> </tr> <tr> <td>CLAY</td> <td>28</td> <td>37</td> </tr> <tr> <td>SHALE</td> <td>37</td> <td>58</td> </tr> <tr> <td>CONFINED AQUIFER ENCOUNTERED AT 59 FEET EXTENDING TO 63'</td> <td>59</td> <td>63</td> </tr> <tr> <td colspan="3">THIS WAS AN OPEN CAVITY BETWEEN THE TWO FOOTAGE LEVELS</td> </tr> <tr> <td colspan="3" style="text-align:center;">(Use a second sheet if needed)</td> </tr>Casing: Material _____ Height: Above or below Threaded _____ Welded _____ Surface 36 in. RMP <input checked="" type="checkbox"/> PVC _____ Weight _____ lbs./ft. Dia. 5 in. to 63 ft. depth Wall Thickness: inches or Dia. _____ in. to _____ ft. depth Gage No. 1200			
					From	To																												
TOP PART	0	2																																
B LIGHT BROWN CLAY	2	25																																
LIGHT BLUE SHALE	25	25																																
CLAY	28	37																																
SHALE	37	58																																
CONFINED AQUIFER ENCOUNTERED AT 59 FEET EXTENDING TO 63'	59	63																																
THIS WAS AN OPEN CAVITY BETWEEN THE TWO FOOTAGE LEVELS																																		
(Use a second sheet if needed)																																		
10. Screen: Manufacturer's name SUNFLOWER PLASTIC PIPE Type 800 Dia. 5 in Stop gauge 1/8 Length 30 Set between 43 ft. and 63 ft. Gravel pack? <input checked="" type="checkbox"/> Size range of material 1/4 - 1/8				11. Static water level: _____ mo./day/yr. 21 ft. below land surface Date 9-20-28																														
				12. Pumping level below land surfaces: _____ ft. after _____ hrs. pumping _____ g.p.m. _____ ft. after _____ hrs. pumping _____ g.p.m. Estimated maximum yield _____ g.p.m.																														
13. Water sample submitted: _____ mo./day/yr. <input type="checkbox"/> Yes <input checked="" type="checkbox"/> No Date _____				14. Well head completion: <input checked="" type="checkbox"/> Pitless adapter 33 Inches above grade																														
				15. Well grouted? YES With: _____ Neat cement _____ Bentonite <input checked="" type="checkbox"/> Concrete Depth: From 3 ft. to 13 ft.																														
16. Nearest source of possible contamination: HOG BARN ft. 500 Direction SW Type HOG BARN Well disinfected upon completion? <input checked="" type="checkbox"/> Yes _____ No				17. Pump: <input checked="" type="checkbox"/> Not installed Manufacturer's name Martin Supply Model number 1 HP _____ Volts _____ Length of drop pipe _____ ft. capacity _____ g.p.m. Type: <input type="checkbox"/> Submersible <input type="checkbox"/> Turbine <input type="checkbox"/> Jet <input type="checkbox"/> Reciprocating <input type="checkbox"/> Centrifugal <input type="checkbox"/> Other																														
				20. Water well contractor's certification: This well was drilled under my jurisdiction and this report is true to the best of my knowledge and belief. MARTIN SUPPLY 362 Business name License No. Address 500 W 22ND Signed Butch Johnson Date 9-20-28 Authorized Representative																														
18. Elevation:		19. Remarks: WELL IS LOCATED 700' FROM BARN YARD UP HILL IN THE FIELD		20. (Continued from previous section)																														

T 23 S R 3 E 0 NE SW 1/4 1/4