


USE TYPEWRITER OR BALL POINT PEN-PRESS FIRMLY, PRINT CLEARLY.

WATER WELL RECORD  
KSA 82a-1201-1215

Kansas Department of Health and Environment-Division of Environment (Water well Contractors) Topeka, Kansas 66620

1. Location of well: County Butler Fraction SW 1/4 SE 1/4 SE 1/4 Section number 10 Township number T 23 S Range number R 3 E

2. Distance and direction from nearest town or city: 2 1/2 miles East of North Edge of Elling Kas  
Street address of well location if in city:  
3. Owner of well: Hugh C Baker  
R.R. or street: Box 226  
City, state, zip code: Newton Kansas

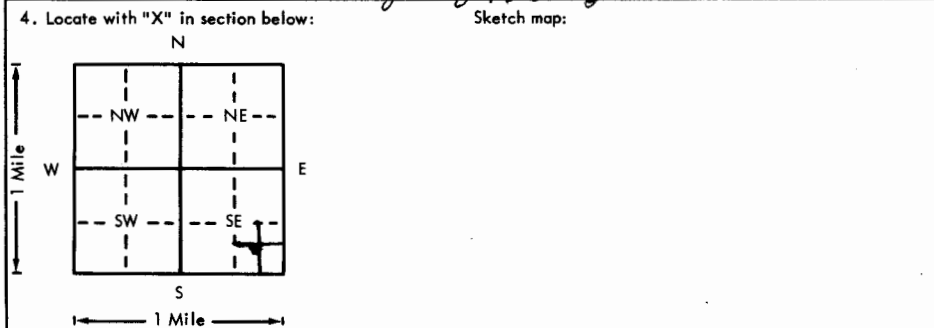

6. Bore hole dia. 7.69 in. Completion date Feb 26 1976  
Well depth 67 ft.  
7.  Cable tool  Rotary  Driven  Dug  
 Hollow rod  Jetted  Bored  Reverse rotary  
8. Use:  Domestic  Public supply  Industry  
 Irrigation  Air conditioning  Stock  
 Lawn  Oil field water  Other  
9. Casing: Material Plastic Height: Above or below  
Threaded  Welded  Surface 24 in.  
RMP  PVC  Weight 900 lbs./ft.  
Dia. 5 in. to 67 ft. depth Wall Thickness: inches or  
Dia.  in. to  ft. depth gage No. 19 1/2

5. Type and color of material	From	To
<u>Black Soil</u>	<u>0</u>	<u>4</u>
<u>Blue Shale</u>	<u>4</u>	<u>12</u>
<u>Clay</u>	<u>12</u>	<u>20</u>
<u>Blue Shale</u>	<u>20</u>	<u>30</u>
<u>Limestone Rock</u>	<u>30</u>	<u>34</u>
<u>Blue Shale</u>	<u>34</u>	<u>56</u>
<u>Rock</u>	<u>56</u>	<u>59</u>
<u>Blue Shale</u>	<u>59</u>	<u>67</u>

10. Screen: Manufacturer's name Sunflow  
Plastic Pipe Inc  
Type Plastic Dia. 5  
Slot/gauze 3/32 Length 2 in  
Set between 30 ft. and 60 ft.  
ft. and 60 ft.  
Gravel pack?  Size range of material 1/4 - 1/2  
11. Static water level: 40 ft. below land surface Date Feb 26 1976 mo./day/yr.  
12. Pumping level below land surfaces:  
40 ft. after 1 hrs. pumping 15 g.p.m.  
     ft. after      hrs. pumping      g.p.m.  
Estimated maximum yield 15 to 20 g.p.m.  
13. Water sample submitted:      mo./day/yr.  
Yes  No  Date       
14. Well head completion:  
 Pitless adapter 26 in Inches above grade  
15. Well grouted?   
With:  Neat cement  Bentonite  Concrete  
Depth: From 4 ft. to 15 ft.  
16. Nearest source of possible contamination:  
ft. 460 Direction SW Type Valley  
Well disinfected upon completion?  Yes  No  
17. Pump:  Not installed  
Manufacturer's name       
Model number      HP      Volts       
Length of drop pipe      ft. capacity      g.p.m.  
Type:  
 Submersible  Turbine  
 Jet  Reciprocating  
 Centrifugal  Other

18. Elevation:  
Topography:  
 Hill  
 Slope  
 Upland  
 Valley  
19. Remarks:  
(Use a second sheet if needed)

20. Water well contractor's certification:  
This well was drilled under my jurisdiction and this report is true to the best of my knowledge and belief.  
Frank Bueckle 221  
Business name License No.  
Address 24 Newton Kansas  
Signed Frank Bueckle Date Feb 26 1976  
Authorized representative

T 23 S R 3 E  
1/4 SW 1/4 SE 1/4