


USE TYPEWRITER OR BALL POINT PEN—PRESS FIRMLY, PRINT CLEARLY.

WATER WELL RECORD  
KSA 82a-1201-1215

Kansas Department of Health and Environment—Division of Environment  
(Water well Contractors)  
Topeka, Kansas 66620

1. Location of well: County Butler Fraction CNE 1/4 NE 1/4 SE 1/4 Section number 15 Township number T 23 S R 3 Range number 3 CEW

2. Distance and direction from nearest town or city: 12 MILE EAST ON 1ST & 1/2 MILE NORTH  
Street address of well location if in city: OF NEWTON, KS.  
3. Owner of well: Henry A Thiessen  
R.R. or street: R3  
City, state, zip code: Newton Kansas

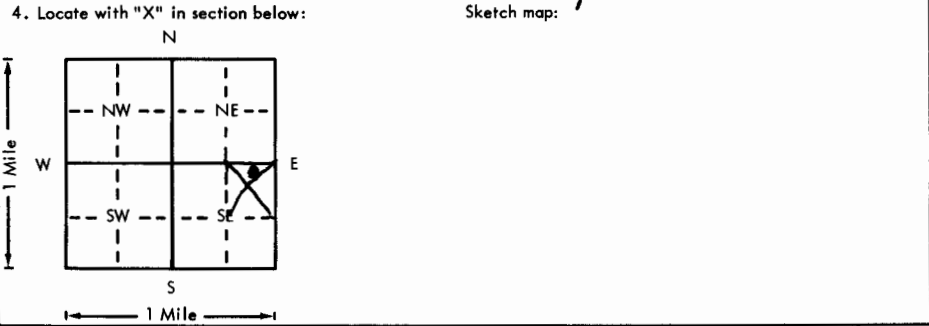

6. Bore hole dia. 8 in. Completion date 4 14 76  
Well depth 67 ft.

7.  Cable tool  Rotary  Driven  Dug  
 Hollow rod  Jetted  Bored  Reverse rotary

8. Use:  Domestic  Public supply  Industry  
 Irrigation  Air conditioning  Stock  
 Lawn  Oil field water  Other

9. Casing: Material PTA Height: Above or below  
Threaded  Welded  Surface 18 in.  
RMP  PVC  Weight 200 lbs./ft.  
Dia. 5 in. to 67 ft. depth Wall Thickness: inches or  
Dia. 5 in. to 67 ft. depth gage No. 216 dia

5. Type and color of material	From	To
<u>Black Dirt</u>	<u>0</u>	<u>3</u>
<u>White clay</u>	<u>3</u>	<u>8</u>
<u>Blue Shale</u>	<u>8</u>	<u>25</u>
<u>Limestone</u>	<u>25</u>	<u>29</u>
<u>gray clay</u>	<u>29</u>	<u>36</u>
<u>Blue Shale</u>	<u>36</u>	<u>55</u>
<u>Rock</u>	<u>55</u>	<u>56</u>
<u>Blue Shale</u>	<u>56</u>	<u>67</u>
(Use a second sheet if needed)		

10. Screens: Manufacturer's name Sunflower  
Plastic pipe Inc  
Type RMP Dia. 3  
Slot/gauze 3/32 Length 36  
Set between 35 ft. and 61 ft.  
ft. and 61 ft.  
Gravel pack?  Size range of material 4 5

11. Static water level: 25 ft. below land surface Date 4 14 76 mo./day/yr.

12. Pumping level below land surfaces:  
25 ft. after 35 hrs. pumping 26 g.p.m.  
ft. after      hrs. pumping      g.p.m.  
Estimated maximum yield 20 g.p.m.

13. Water sample submitted:      mo./day/yr.  
 Yes  No Date     

14. Well head completion:  
 Pitless adapter 18 Inches above grade

15. Well grouted?   
With:  Neat cement  Bentonite  Concrete  
Depth: From 0 ft. to 10 ft.

16. Nearest source of possible contamination: BARNYARD  
ft. 100 Direction SW Type       
Well disinfected upon completion?  Yes  No

17. Pump:  Not installed  
Manufacturer's name       
Model number      HP      Volts       
Length of drop pipe      ft. capacity      g.p.m.  
Type:  
 Submersible  Turbine  
 Jet  Reciprocating  
 Centrifugal  Other

18. Elevation:       
19. Remarks:       
Topography:  
 Hill  
 Slope  
 Upland  
 Valley

20. Water well contractor's certification:  
This well was drilled under my jurisdiction and this report is true to the best of my knowledge and belief.  
Frank Boudch 221  
Business name License No.  
Address Newton Kansas  
Signed Frank Boudch Date 4 14 76  
Authorized representative

23-3W-15 CNE SE 1/4