


USE TYPEWRITER OR BALL POINT PEN-PRESS FIRMLY, PRINT CLEARLY.

WATER WELL RECORD
KSA 82a-1201-1215

Kansas Department of Health and Environment-Division of Environment
(Water well Contractors)
Topeka, Kansas 66620

1. Location of well: County BUTLER Fraction SW 1/4 NE 1/4 NW 1/4 Section number 17 Township number T 23 S Range number R 3 E E/W

2. Distance and direction from nearest town or city:
Street address of well location if in city: 118 2nd & Regier
3. Owner of well: Edwin Andres
R.R. or street: 118 2nd & Regier Box 113
City, state, zip code: Elbing, Kansas

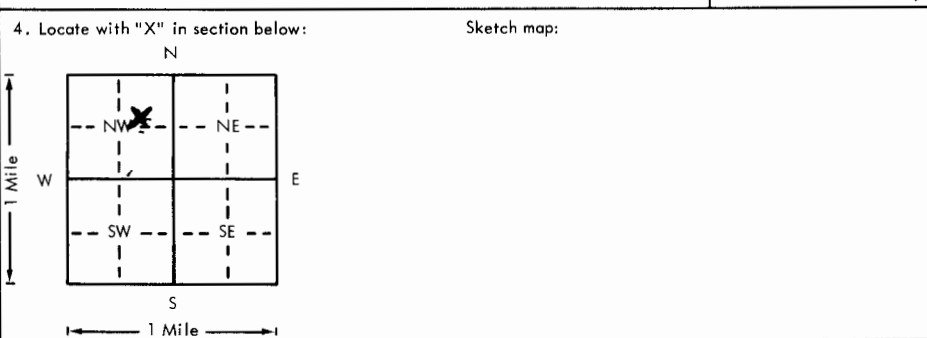

6. Bore hole dia. 8 in. Completion date 10-14-78
Well depth 72 ft.

7. Cable tool Rotary Driven Dug
 Hollow rod Jetted Bored Reverse rotary

8. Use: Domestic Public supply Industry
 Irrigation Air conditioning Stock
 Lawn Oil field water Other

Casing: Material Plastic Height: Above or below
Threaded Welded Surface 18 in.
RMP PVC Weight _____ lbs./ft.
Dia. 12 in. to 12 in. depth Wall Thickness: inches or
Dia. _____ in. to _____ ft. depth gage No. 200

5. Type and color of material	From	To
<u>CLAY</u>	<u>0</u>	<u>15</u>
<u>GRAY CLAY</u>	<u>15</u>	<u>30</u>
<u>SLATE</u>	<u>30</u>	<u>45</u>
<u>CLAY</u>	<u>45</u>	<u>72</u>
(Use a second sheet if needed)		

Screen: Manufacturer's name Sunflower Plastic Pipe
Type 200 Dia. 5"
Slot/gauze Slot 1/8 Length 20'
Set between 52 ft. and 72 ft.
Gravel pack? Yes Size range of material 4-1/2

11. Static water level: _____ mo./day/yr.
21 ft. below land surface Date 10-14-78

12. Pumping level below land surfaces:
_____ ft. after _____ hrs. pumping _____ g.p.m.
_____ ft. after _____ hrs. pumping _____ g.p.m.
Estimated maximum yield 10 g.p.m.

13. Water sample submitted: _____ mo./day/yr.
 Yes No Date _____

14. Well head completion:
 Pitless adapter 18 Inches above grade

15. Well grouted? Yes
With: Neat cement Bentonite Concrete
Depth: From 0 ft. to 10 ft.

16. Nearest source of possible contamination:
ft. 100 Direction W Type SEWER
Well disinfected upon completion? Yes No

17. Pump: Not installed
Manufacturer's name 660123
Model number 10270348 HP 1/2 Volts 230
Length of drop pipe 65 ft. capacity 10 g.p.m.
Type: Submersible Turbine
 Jet Reciprocating
 Centrifugal Other

18. Elevation:
Topography:
 Hill
 Slope
 Upland
 Valley

19. Remarks:

20. Water well contractor's certification:
This well was drilled under my jurisdiction and this report is true to the best of my knowledge and belief.
Business name Martin Supply 362 License No. _____
Address 500 West 2nd, N. Newton
Signed Dutch Kanda Date 10-14-78

T 23 S
 R 3 E
 Sec 17
 1/4 NW 1/4
 SW 1/4
 SE 1/4
 NE 1/4